


AN EXHIBIT FOR THE CITY OF TEMPE, ARIZONA

Delineating The Alignment And Location Of A Proposed 10' Wide Electric Power Easement Along The Tempe Town Lake Within Portions Of Sections 14, 15, And 16, Township 1 North, Range 4 East, Of The Gila And Salt River Base And Meridian.

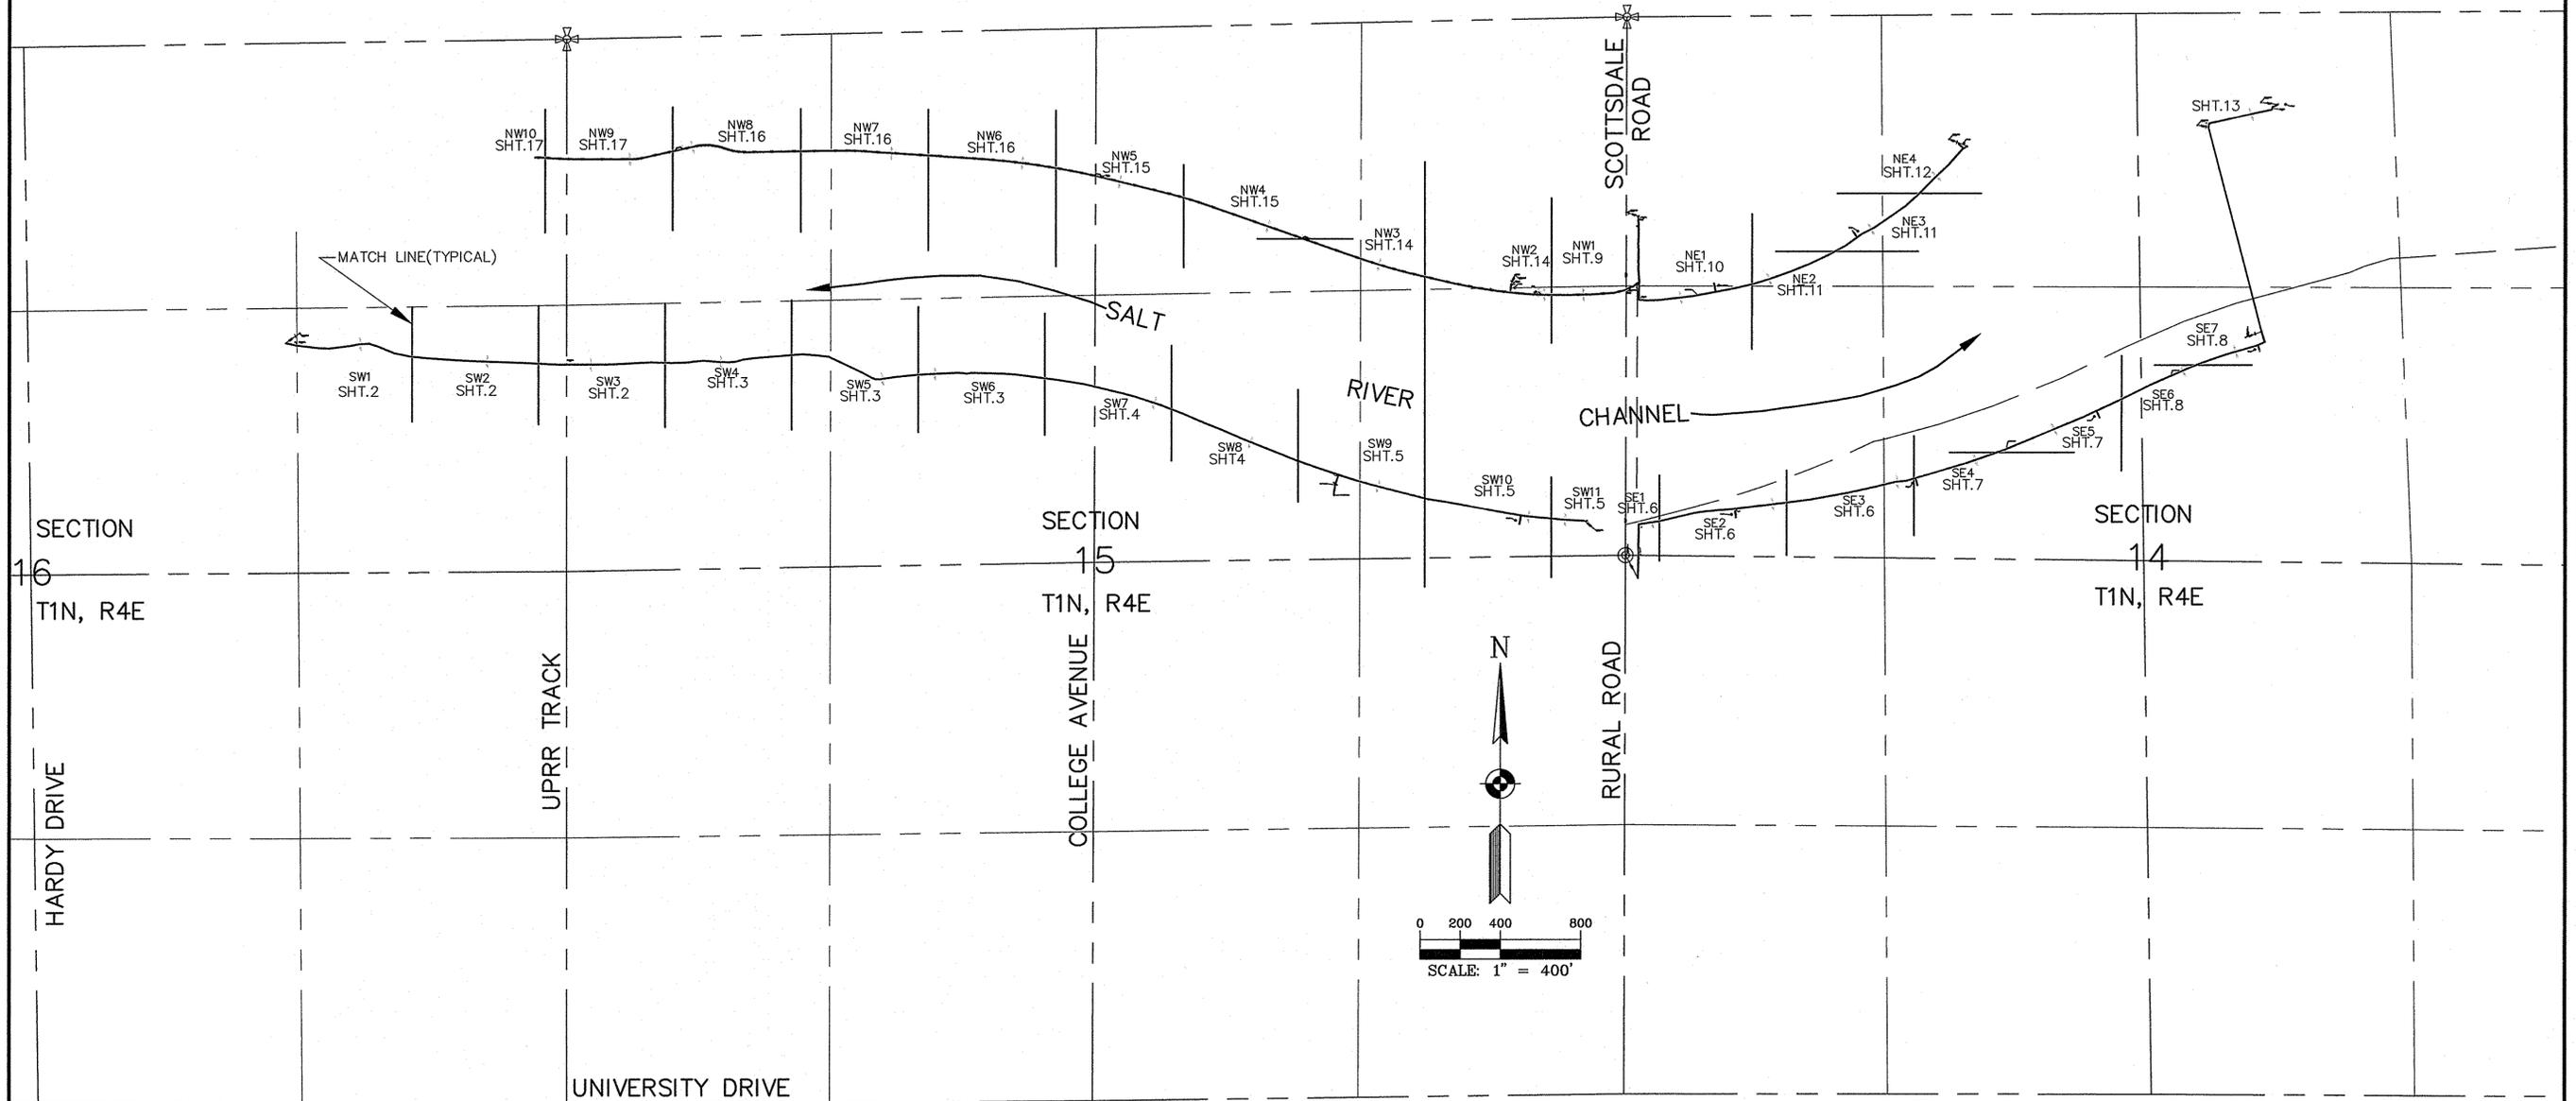

- NOTE:
1. All Coordinates = City Of Tempe Datum
 2. Bearings Are Based On City Of Tempe Datum.
 3. This Exhibit Is Being Recorded To Provide A Reference Document For A Non-exclusive Easement To Be Granted To Arizona Public Service Over The Area Shown Hereon (Tempe Town Lake) (Well Numbers, Etc. Are From Tempe Town Lake Construction Documents).
 4. The Actual Non-exclusive Easement Will Be Granted By Separate Instrument Using This Document As A Reference.
 5. The Alignment Shown Is The Actual As-built Location Of The Electric Power Line As Surveyed By Morrison - Maierle, Inc., During The Months Of January And February, 1999.

NO.	DESCRIPTION	DATE	BY

COPYRIGHT 2000
 MORRISON MAIERLE, INC.
 HEREBY PRESERVES OUR COMMON LAW
 COPYRIGHT IN THIS DOCUMENT AND THE
 IDEAS AND DESIGNS INCORPORATED
 THEREIN. ANY REPRODUCTION OR
 PROFESSIONAL SERVICE WHICH SHALL
 NOT BE USED IN WHOLE OR IN PART
 WITHOUT OUR EXPRESS WRITTEN
 AUTHORIZATION.

ENGINEERS
 SCIENTISTS
 SURVEYORS
 PLANNERS

MORRISON MAIERLE, Inc.
 an Arizona Corporation

120 N 4th Street, Suite 410
 Phoenix, AZ 85004-1822
 Phone: (602) 244-9862
 Fax: (602) 244-9872

DRAWN BY: SWJD	BY: JGS
CHKD BY: JGS	DATE: AUG 00
APPR BY: JGS	Q.A. REVIEW
DATE: AUG 00	DATE:

TEMPE TOWN LAKE

ELECTRICAL LINE
 DESCRIPTION

PROJECT NO.
 8176011

SHEET NUMBER
1 OF 17