APS FIELD BOOK RECORD

BOOK E15

Western District Power line

1937 to 1939

Note: The cover of the field book was to dark to scan/photo copy. This sheet was made to identify the field book pages source.

3-15-2007 BD

DIN# 46838-1

66

WA 882
ECL 51
W-208-5B
4/17/34
Copley
Sterling
Drurriamond

THIS LAY OUT Void SEE NEXT PAGE

Extend 3ϕ 11kv. to Sarre Well for
Caley Abbott NW Cor Sec C T 15 R 3 W.

Sta	+	- Cod	∠	Elev	Location
Occupy 1+08	103.88				
B.S. 100.00					
= Top N. Pole					
1+08		5.30		98.58	Grd. N. Pole
1+33		5.50		98.38	Grd. at Fol. xing
1+33			+31°25'	121.01	Wires
1+25		3.88		100.00	Top N. Pole
1+97.5		7.65		96.23	Grd. W.O.
1+97.5			+11°15'	121.68	Wires
3+11		7.35		96.53	Grd. Soo. Pole
N. Pole					
Elev. 40' pole =	131.08				
S. Pole				96.53	
Elev. 40' pole	129.03			38	
				134.53	
				1	
				133.53	
6.50 in grd.		4.00		96.53	98.58
1.00 below top		2.75		32.5	32.50
7.50		3.25		129.03	131.08

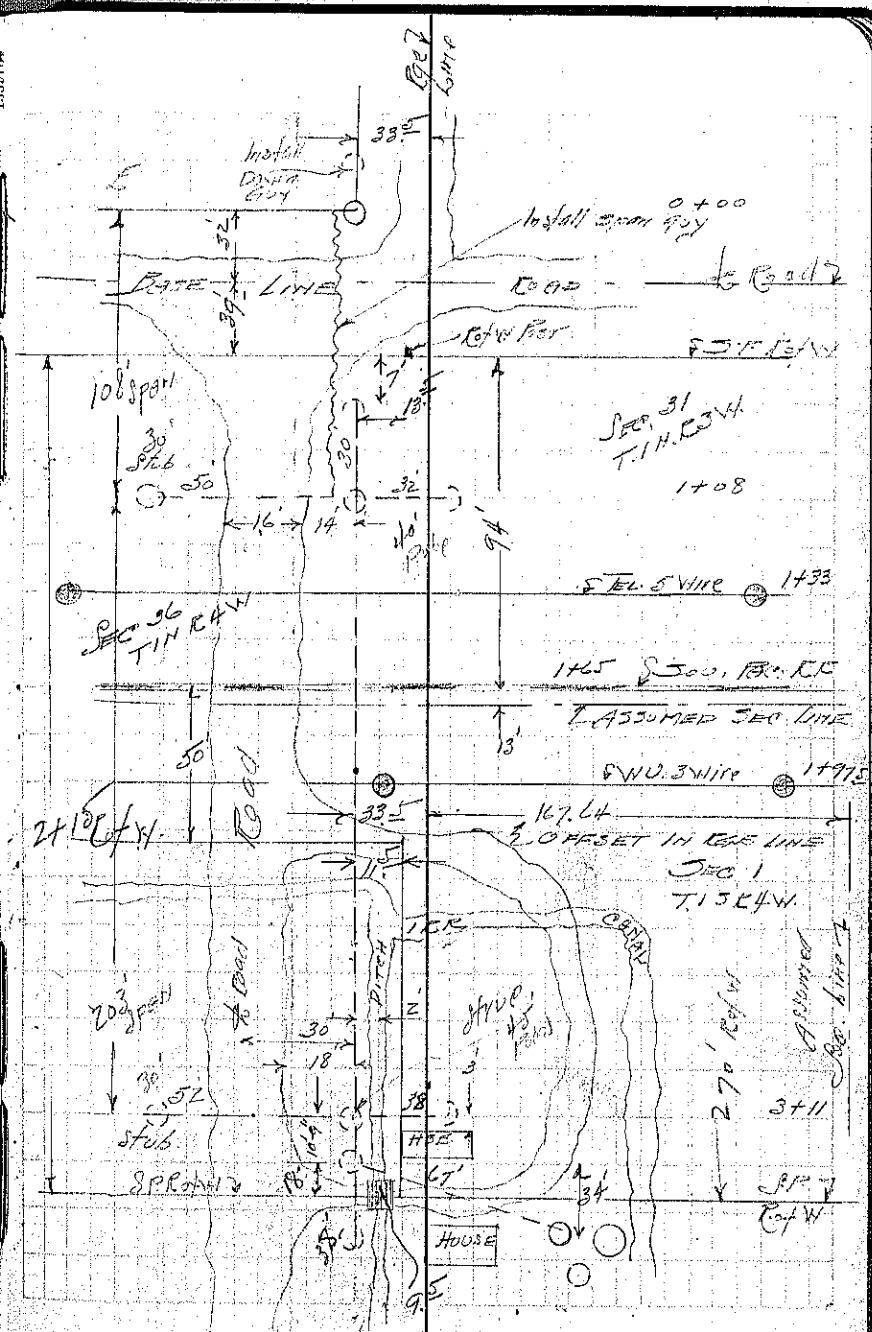

67

5114.2
164.5
5278.7 Actual

5121
122
39
5278.7

NE Cor Sec 6 — 1714+03.40 / 1662+19.65 / 52+83.75

NW Cor Sec 6 — No. 3P Flat 1929 — " " " "

52+83.75
52+78.70 Actual
5.05 Diff

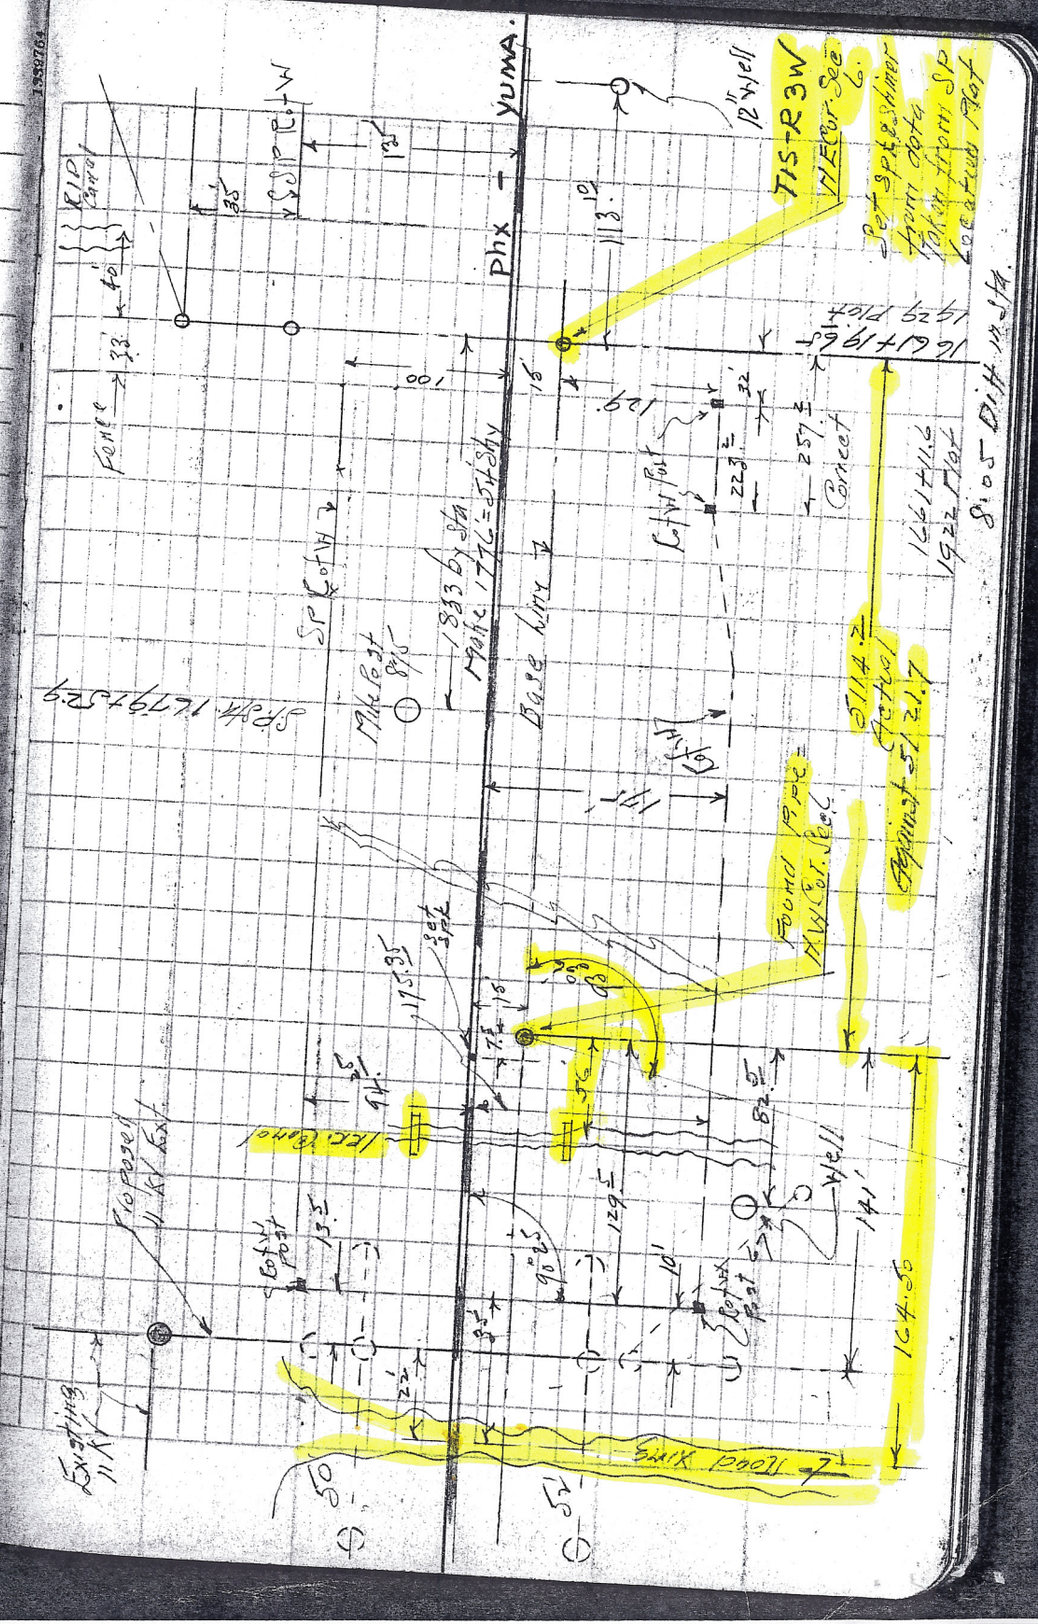
Phx → Yuma
T1S-R3W
Set Spike & Shiner
Found Iron Pipe
Found Pipe
Base Line
Spike 1679+52.9
1883 by Sta.
Traffic 1776 = Easterly
Proposed 11 KV Exist
Existing 11 KV

C.C.C. Camp

W.A. #318

Apr. 24-25-26 1939

Sterling Drainage

20 21
29 28
T15 R3W

1813 Highway Ties to Sec Cor
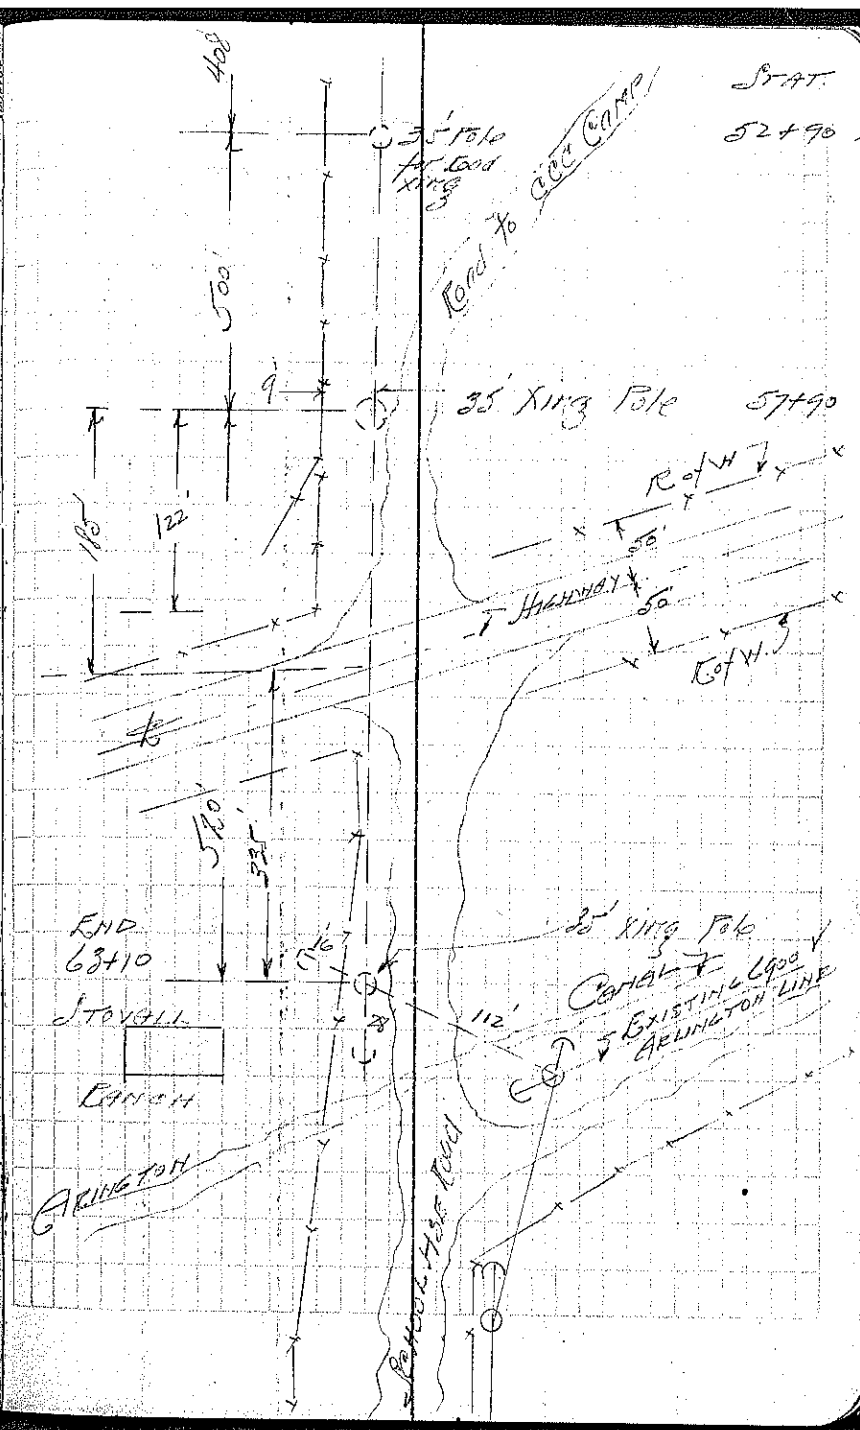
7 - 35' Line Poles
8 - 30' " "
1 - 30 Sta Pole