FED. ROAD DIV. NO.	STATE	PROJECT NO.	SHEET NO.	TOTAL SHEETS	AS BUILT
7	ARIZ.	S 292 (1)	1	23	S.M.H. 11-10-59
7	ARIZ.	S-292 (2)	1	7	
7	ARIZ.	S-360(1)	1	11	
7	ARIZ.	S-292 (3)	1	8	
7	ARIZ.	S 368(1)	1	17	
7	ARIZ.	NON-S 371(1957)A	1	11	

PLANS DIVISION
1
FILE COPY

PLANS DIVISION
1
FILE COPY

STATE OF ARIZONA
STATE HIGHWAY DEPARTMENT

PLAN AND PROFILE OF PROPOSED

COUNTY HIGHWAY
MARICOPA COUNTY

NON S 371(1957)A
S-292(2)
As Built

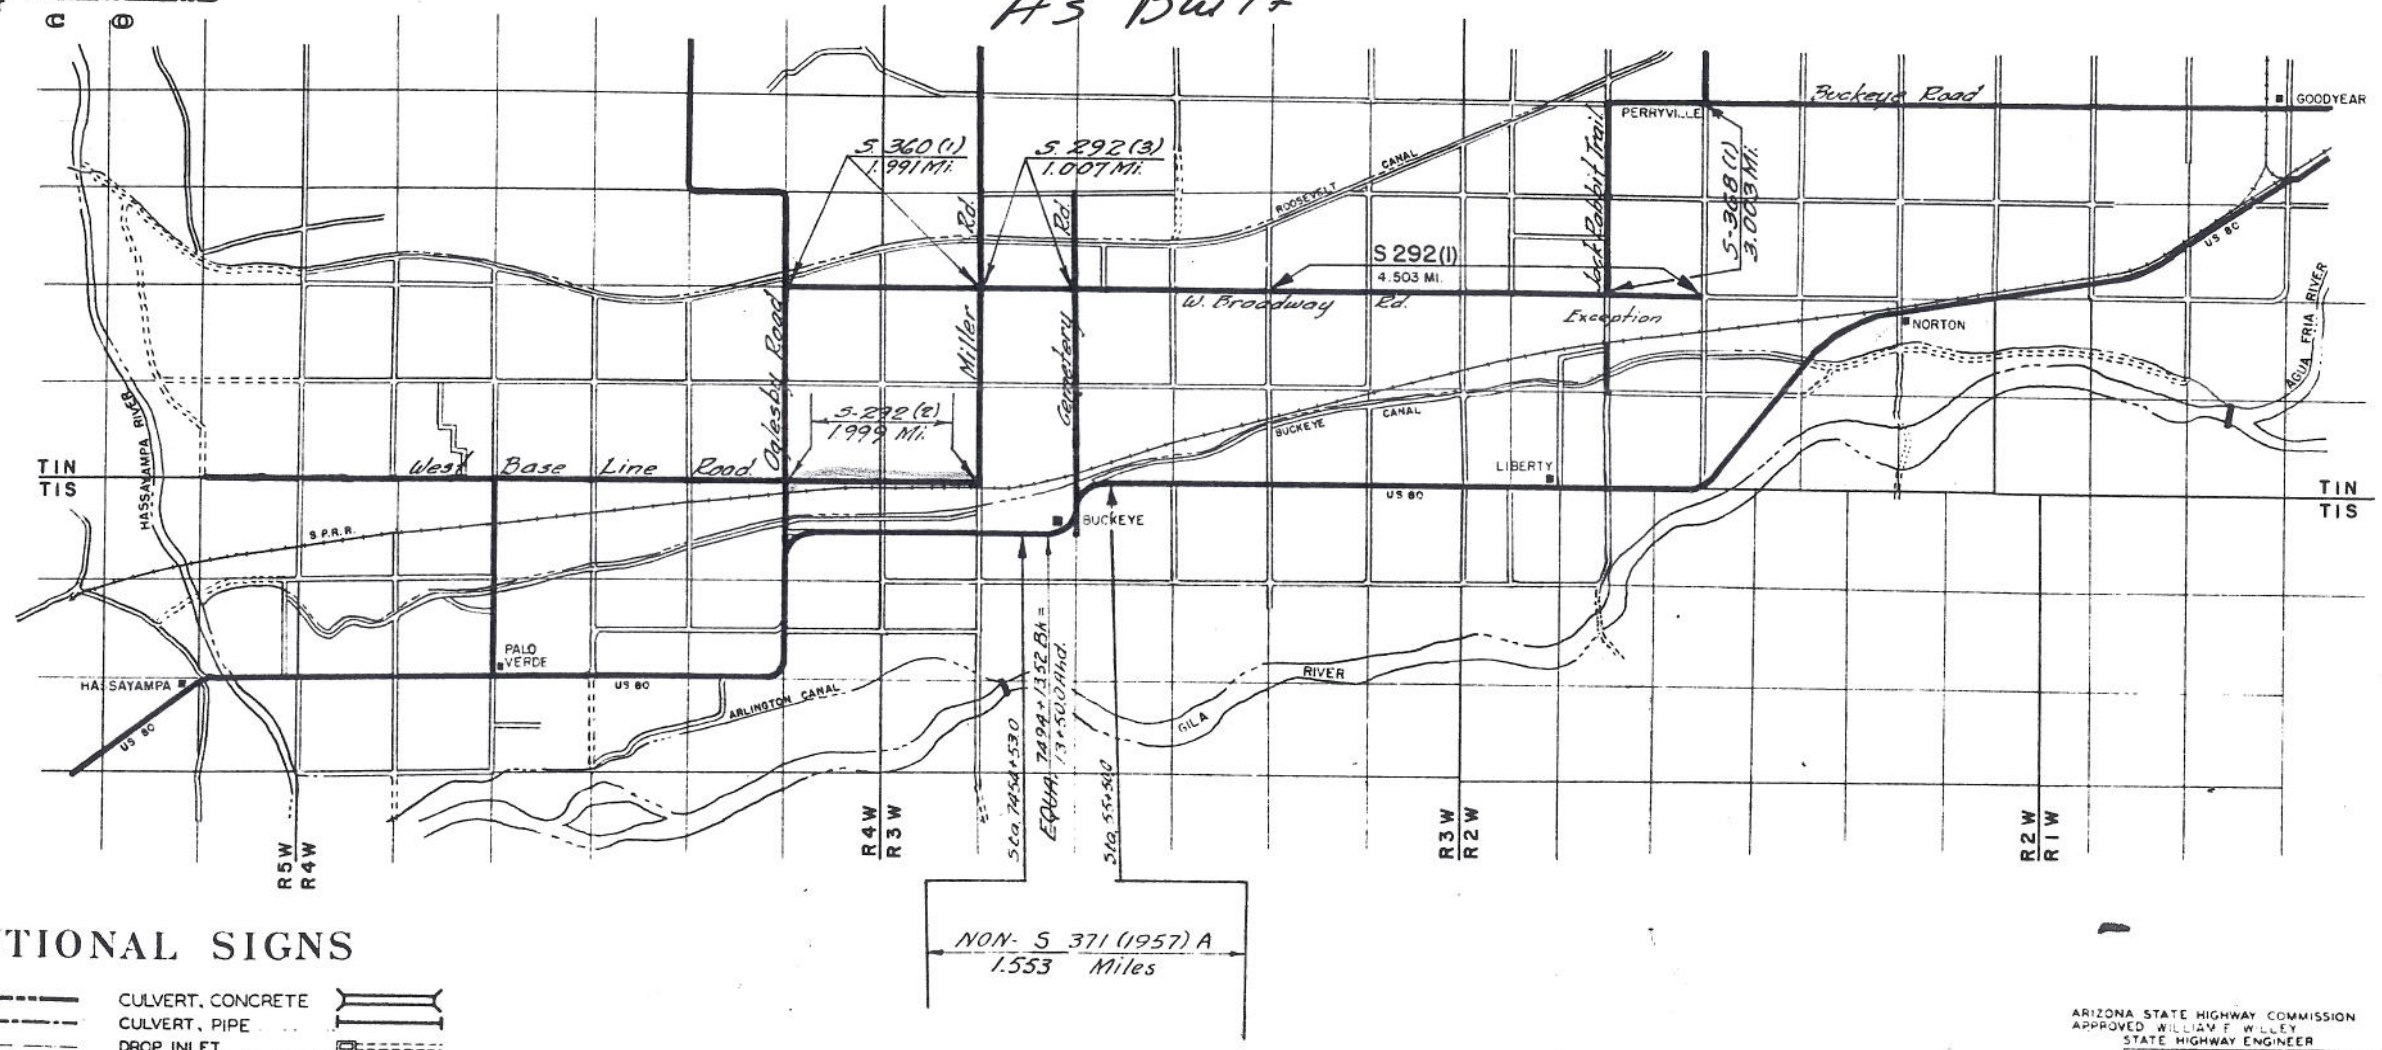

CONVENTIONAL SIGNS

- STATE AND NATIONAL LINE
- COUNTY LINE
- CITY, VILLAGE OR BOROUGH
- TOWNSHIP LINE
- SECTION LINE
- GRANT LINE
- FENCE LINE
- ROAD GUARD
- UNFENCED PROPERTY
- RIGHT OF WAY LINE
- TRAVELED WAY
- RAILROAD
- RETAINING WALL
- BASE OR SURVEY LINE
- ROAD TRAFFIC SIGN
- CULVERT, CONCRETE
- CULVERT, PIPE
- DROP INLET
- CATTLE GUARD
- POWER POLE
- TELEPHONE POLE
- CHANNEL OR DITCH
- DIKE
- GUIDE POST
- BRIDGE
- GRADE LINE
- GROUND LINE
- SECTION CORNER (FOUND)
- R/W LINE MARKER
- TREES AND SHRUBS

ARIZONA STATE HIGHWAY COMMISSION
APPROVED WILLIAM F. WILLEY
STATE HIGHWAY ENGINEER

DATE _____ DEP STATE ENGINEER

RECOMMENDED FOR APPROVAL

DATE _____ DISTRICT ENGINEER

RECOMMENDED FOR APPROVAL

DATE _____ BRIDGE ENGINEER

RECOMMENDED FOR APPROVAL

DATE _____ ENGINEER OF PLANS

DEPARTMENT OF COMMERCE
BUREAU OF PUBLIC ROADS

APPROVED _____ DATE _____

DISTRICT ENGINEER

W. BASE LINE ROAD
MARICOPA COUNTY

FED. ROAD DIV. NO.	STATE	PROJECT NO.	SHEET NO.	TOTAL SHEETS	NO. DUPLICATE
7	ARIZ.	S-292 (2)	2	7	7-11 S-30

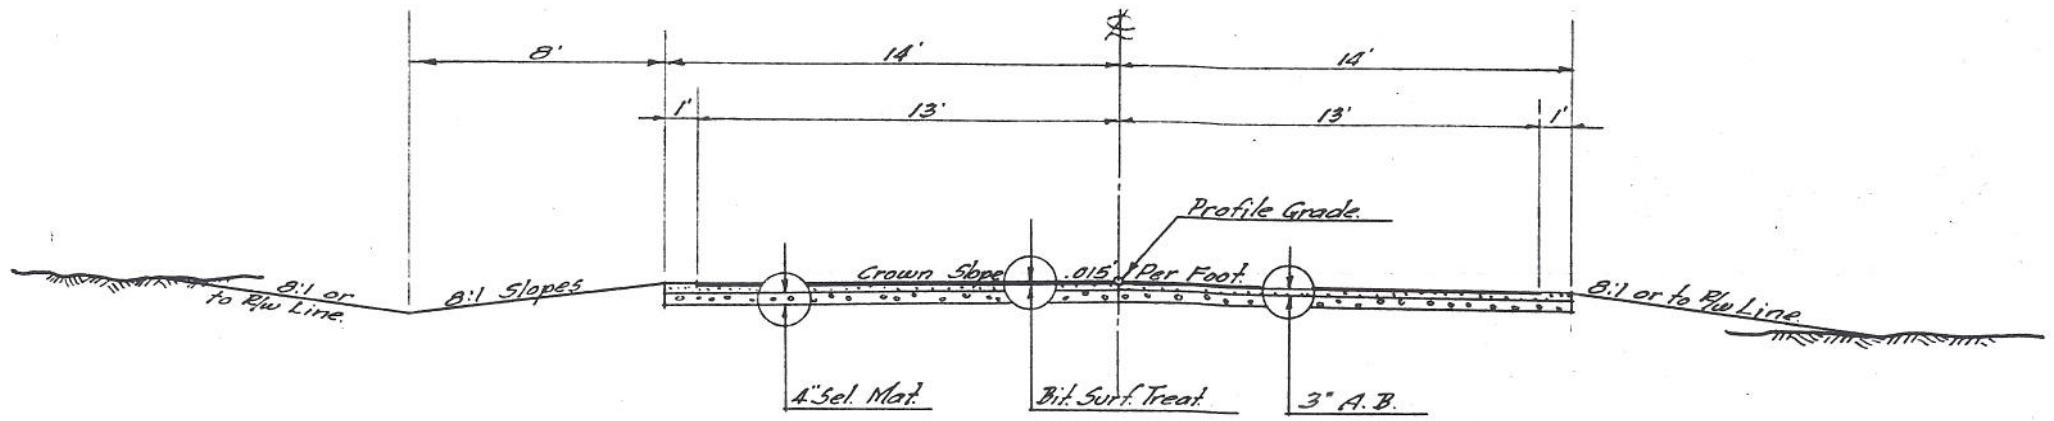

TYPICAL SECTION

GUIDE POSTS

16 New Type B Guide Posts.

SURVEY MONUMENTS

2 New Std. Survey Monuments & Covers (Maricopa Co Standard)

LENGTH OF PROJECT

Sta. 158+60.04 to 166+10.00 = 749.96'
" 166+09.07 to 264+15.00 = 9805.93'
Total = 10,555.89' or 1.999 Miles =
Net Length of Project S-292 (2).

MISCELLANEOUS PIPES

Station	Pipe in Place.	New Pipe.	Headwalls
158+18	18"x52' Conc. Pipe ~ No Change.		
161+30	24"x90' C.M.P. ~25° Sk. Lt. ~ No Change.		
185+82	24"x36.4' C.M.P.	Extend 8' Lt & 4' Rt.	2 New Str. Conc. Hdwls
198+59	24"x40.5' C.M.P. ~ Remove.	24"x48' Conc. Pipe	2 " " " "
212+40	24"x40.5' C.M.P.	Extend 4' Lt & 4' Rt.	2 " " " "
222+69.5	24"x40.5' C.M.P. ~ Remove	24"x48' Conc. Pipe	2 " " " "
Lt 223+65	12"x18' Conc. Pipe ~ Remove.	18"x18' Conc. Pipe.	No Headwalls.
238+87	24"x40.5' C.M.P. ~ Remove	24"x48' Conc. Pipe	2 New Str. Conc. Hdwls.
263+54	18"x45' Conc. Pipe ~ No Change.		
Rt 264+25	24"x44' " " ~ No Change.		
Lt 186+10	None.	18"x30' Conc. Pipe	None

All Conc. Pipe to be Reinforced.
All C.M.P. to be Bituminous Coated.

GENERAL NOTES

Engineer shall locate and set project markers, bench markers etc. furnished by County.
See standard pamphlet regarding signing and marking of Detours & Temporary Routes.

Non F.A.
Extend Proj. 1.1 Mile
East with Seal Coat.
C.O. #1

INDEX TO SHEETS

Sheet #1	Face Sheet.
Sheet #2	This Sheet.
Sheets #3 to #7	Plan & Profile.
Standards.	
Maricopa Co. Std.	Survey Monuments & Covers.
State Std. C-3	Turnouts.
" Std. C-8	Guide Posts.
" Std. C-9	Conc. Headwalls.
" Std. C-33	Conc. Pipe Installation.
" Std. C-38	Proj. Markers, Bench Markers etc.

REDUCED SIZE
DO NOT SCALE

FED ROAD DIV. NO.	STATE	PROJECT NO.	SHEET NO	TOTAL SHEETS	AS BUILT
7	ARIZ	S-292(2)	3	7	JMH 5-56

ASE LINE ROAD
MARICOPA COUNTY

Sta. 158+59.88 -- Set nail 33' Lt. of Approx. Sec. Cor.

I. 4°24' Lt.
D 2°00'
R 2864.79
a 1
o .58'
t 100'
Δs 200'
Δc 0°24'
Lc 20'
Tc 210.09'
PI 159+76.13
Super .015'/Ft.

Sta. 161+30 -- 25° Sk. Lt. 24" x 90' C.M.P. In place No Change.

157+60.04 P.T.S. Office Location

160' ± 20' Dirt Road

159+60.04 S.C.

159+80.04 C.S.

161+80.04 S.T.

155

160

165

170

N. 89° 28' 00" E.

N. 89° 24' 00" E.

Base Line -- N. 89° 24' 00" E.

33'

38'

35

36

1

2

3

T. 1 S.

R. 4 W.

E.P. ⅝" Iron Pin

Sta. 158+18 In place 18" x 52' Conc. Pipe -- R. Hdwls No Change.

Sta. 158+60.04 POST Sec. Cor. & Angle Point Δ 0°04' Lt. -- ⅝" Iron Pin

BEGIN S-292(2)

Set New Std Survey Mon. & Cover.

Approx. Sec. Cor. Not Found Locate Cor. & Set new Survey Mon. & Cover.

Obliterate Exist. 18' Mix. Dirt Pvmt.

108' ± 20' Dirt Road

Sta. 161+90.00 T.S.

200' R.

Conc. Curbed

24" x 16' Conc. Pipe

20 wire Gate

11 wire Gate

Stucco House

Sta. 164+10.00 C.S.

I. 4°24' Rt.
D 2°00'
R 2864.79'
a 1
o .58'
t 100'
Δs 200'
Δc 0°24'
Lc 20'
Tc 210.09'
PI 164+00.09 P.I.
Super .015'/Ft.

Office Loc. 166+09.07 P.O.T. Alhd Survey

EQUA 166+10.00 Bk. =

N

REDUCED SIZE
DO NOT SCALE

BM #16, 47' Lt. Sta. 158+87
R.R. Spike in power Pole, Elev. 895.13

Lt. Sta. 157± New 250' B.S.T. Taper

Lt. Sta. 158+60± New 20' x 30' B.S.T. Turnout

Rt. Sta. 160+08± New 20' x 30' M.B. Turnout

893.40

893.28

898.40

895

890

885

-0.03%

-0.11%

Sta. 158+18 In place 18" x 52' Conc. Pipe No Change

Sta. 161+30 In place 24" x 90' C.M.P. No Change

S.K.G. 272.1

BASE LINE ROAD
MARICOPA COUNTY

FED ROAD DIV NO	STATE	PROJECT NO	SHEET NO	TOTAL SHEETS
7	ARIZ	S-292 (2)	5	7

N 89° 16' 30" E

Southern Pacific Railroad

Base Line — N 89° 16' 30" E

P.O.T. 12+00.00

R.P. 5/8" Iron Pin

10'x 45' Conc. Pipe. No Change.

Sta. 212+40 In Place
24" x 40.5' C.M.P.
Extend 4' Rt. & 4' Lt.
2 New Str. Conc. Hdwls.

R.P. Structure #874.07
24" x 24.5' Conc. Pipe
2 - 3'x 8' Conc. Hdwls.

147.5' Rt. Sta. 211+68.3 Sec. Cor. Found 3/4" Iron Pin

T. 1 N. R. 4 W. — 36
T. 1 N. R. 3 W. — 31

Approx. Sec. Cor. Not Found.

B.M. #21, 32.5' Lt. Sta. 209+20
RR Spike in Power Pole, Elev. 892.33

Lt. Sta. 212+05
New 24" x 30' B.S.T. Turnout

Rt. Sta. 211+45
New 16" x 30' B.S.T. Turnout

Sta. 212+40 In Place
24" x 40.5' C.M.P.
Extend 4' Rt. & 4' Lt.
2 New Str. Conc. Hdwls.

Sta. 212+40
24" x 48' Conc. Pipe
2 New Str. Conc. Hdwls.

892.01 — Level — 891.37 — −0.16% — 892.01 — +0.16% — 891.02 — −0.33%

925.5 C.Y. Bor. from Pit

Lt. Sta. 223+65
Remove 12" x 18' Conc. Pipe
New 18" x 18' Conc. Pipe
No Hdwls

P.O.T. 22+60.00

R.P. 5/8" Iron pipe

In place — Sta. 222+69.5
Remove 24" x 40.5' C.M.P.
New 24" x 48' Conc. Pipe.
2 New Str. Conc. Hdwls.

R.R. Structure #874.55
27.5' x 15.5' Wood Bridge
82.6 ft Effective Opening

B.M. #22, 99' Rt. Sta. 219+40
R.R. Spike in Tele. Pole, Elev. 889.53

SEC. 6 — T. 1 S. R. 3 W.

B.M. #25, 99' Rt. Sta. 229+96
RR Spike in Tele. Pole, Elev. 889.87

Sta. 222+69.5
Remove 24" x 40.5' C.M.P.
New 24" x 48' Conc. Pipe
20 C.Y. Str. Exc.
2.0 C.Y. Conc.
90 # Reinf. Steel

Lt. Sta. 223+65
New 10" x 10' B.S.T. Turnout

Sta. 229+65
Remove 12" x 18' Conc. Pipe
New 18" x 18' Conc.
C.Y. Str. Exc.

889.97 — −0.15% — Level

Exc. 195.2

REDUCED SIZE
DO NOT SCALE

BASE LINE ROAD
MARICOPA COUNTY.

FED. ROAD DIV. NO.	STATE	PROJECT NO.	SHEET NO.	TOTAL SHEETS
7	ARIZ.	S-292 (2)	4	7

SEC. 36
T. 1 N. R. 4 W.

P.O.T. 172+00.00 Set 5/8" Iron Pipe

R.P. 5/8" Iron Pin

N. 89° 24' 00" E.

N. 89° 24' 00" E – Base Line.

P.C. 194+17.30 Set 5/8" Iron Pin

P.T. 195+66.60 Set 5/8" Iron Pin

REDUCED SIZE
DO NOT SCALE

SEC. 1
T. 1 S. R. 4 W.

B.M. #17, 30' Lt. Sta. 171+10
R.R. Spike in Power Pole, Elev. 893.32

B.M. #18, 29.5' Lt. Sta. 178+83
R.R. Spike in Power Pole, Elev. 892.70

Lt. Sta. 183+09
New 10 x 10' B.S.T. Turnout

893.40

891.56

– 0.07 %

Level

638.7 C.Y. Bor. from Pit

Exc.	542.7
20% Str.	108.5
Bor.	638.7
15% Str.	95.8
Emb.	871.1
Gr. Comp.	866.0

10'x16' Conc. Pipe
6"x6" Conc. Hdwls.
No Change

Lt. Sta. 186+10
New 18"x30' Conc. Pipe
No Headwalls

P.T. 188+89.14 Set 5/8" Iron Pin

R.P. 5/8" Iron Pin

N. 87° 29' 00" E.

R.P. 5/8" Iron Pin

R.R. Hwy. Rte 3

Δ 6°47'30" Rt.
D 1°00'
R 5729.58'
T 339.99'
L 679.16'
Super .015/ft.

P.C. 192+26.05 Set 5/8" Iron Pin

P.T. 199+05.21 Set 5/8" Iron Pin

R.P. 5/8" Iron Pin

N. 89° 16' 30" E

POST 185+82
24"x36.4' C.M.P. in Place
15 C.Y. Str. Exc.
Extend 8' Lt. & 4' Rt.
2 New Str. Conc. Hdwls.

R.P. Structure #873.86
24"x26.5' Conc. Pipe
9"x8' Conc. Hdwls.

186+54.3 P.I. 5/8" Iron Pin

Δ 6°55'00" Lt.
D 2°00'
R 2864.79'
T 173.13'
L 345.84'
Super .015/ft.

Southern Pacific Railroad

Structure #874.0
2-3'x3' Signal Towers

B.M. #19, 45.5' Lt. Sta. 189+10
R.R. Spike in Power Pole, Elev. 892.89

B.M. #19-A, 100' Rt. Sta. 193+80
U.S.C.&G. Brass Cap set in Conc. Elev. 891.11

R.P. Structure #874.09
29'x15.5' Wood Bridge
72.5° Effective Opg.

B.M. #20, 35' Lt. Sta. 199+18
R.R. Spike in Power Pole, Elev. 891.16

Sta. 185+82 POST
24"x36.4' C.M.P. in place
Extend 8' Lt. & 4' Rt.
15 C.Y. Str. Exc.
20 C.Y. Str. Conc.
90 M Lbs. Steel

Lt. Sta. 186+10
New 18"x30' Conc. Pipe
15 C.Y. Str. Exc.

Lt. Sta. 186+10
New 10'x10' B.S.T.
Turnout

891.56

892.01

Level

+0.09%

Sta. 199+53 To Replace
24"x40.5' C.M.P. Culvert
New 24"x40' Conc. Pipe
2.3 New Str. Conc. Hdwls.



1567.5 C.Y. Bor. from Pit

Exc.	127.6
20% Str.	25.5
Bor.	1567.5
15% Str.	235.1

FED ROAD DIV NO	STATE	PROJECT NO	SHEET NO	TOTAL SHEETS	NO BUILT
7	ARIZ	S-272 (2)	6	7	

BASE LINE ROAD
MARICOPA COUNTY

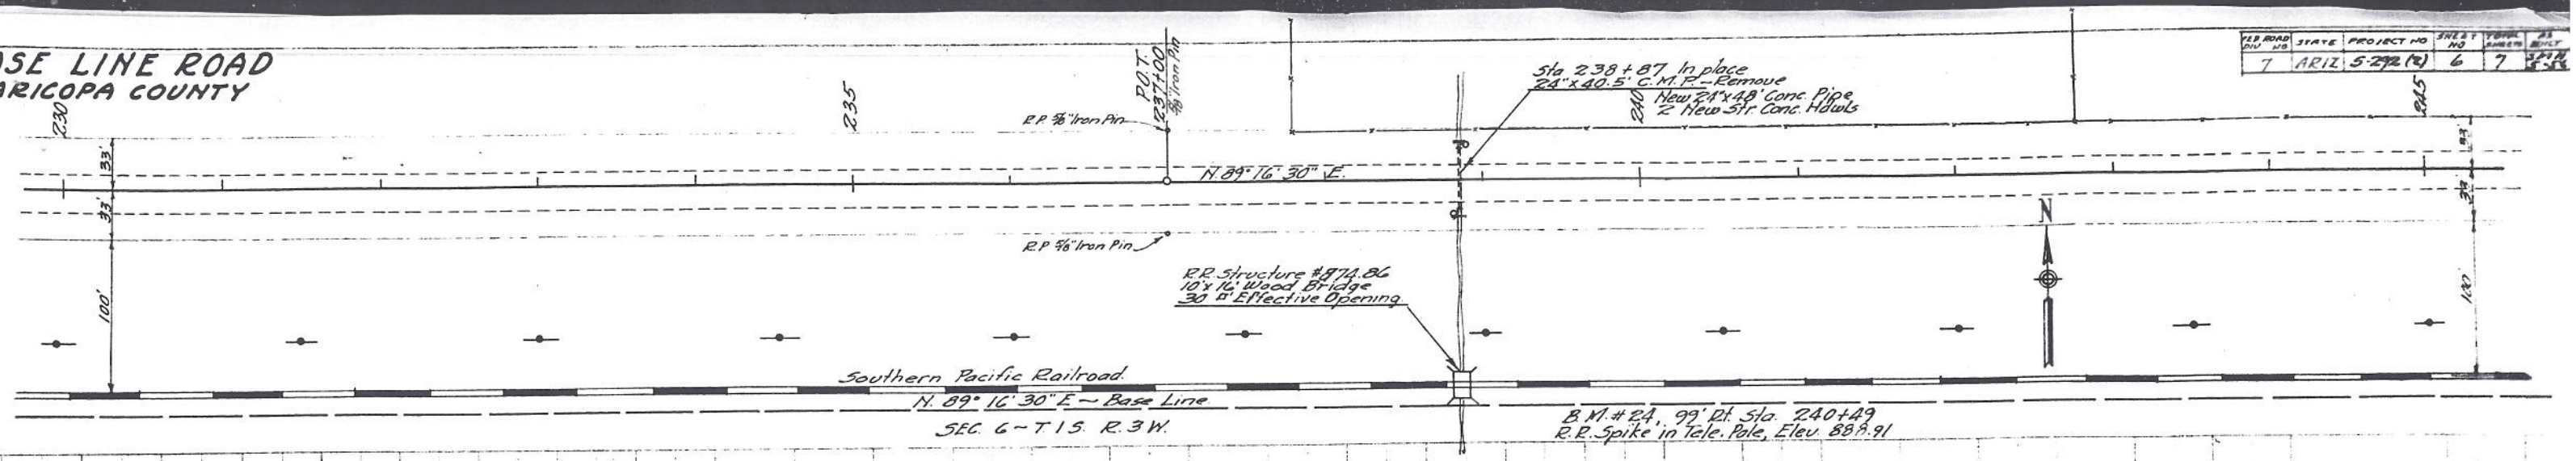

BASE LINE ROAD
MARICOPA COUNTY

FED. ROAD DIV. NO.	STATE	PROJECT NO.	SHEET NO.	TOTAL SHEETS
7	ARIZ.	S 292 (2)	7	7
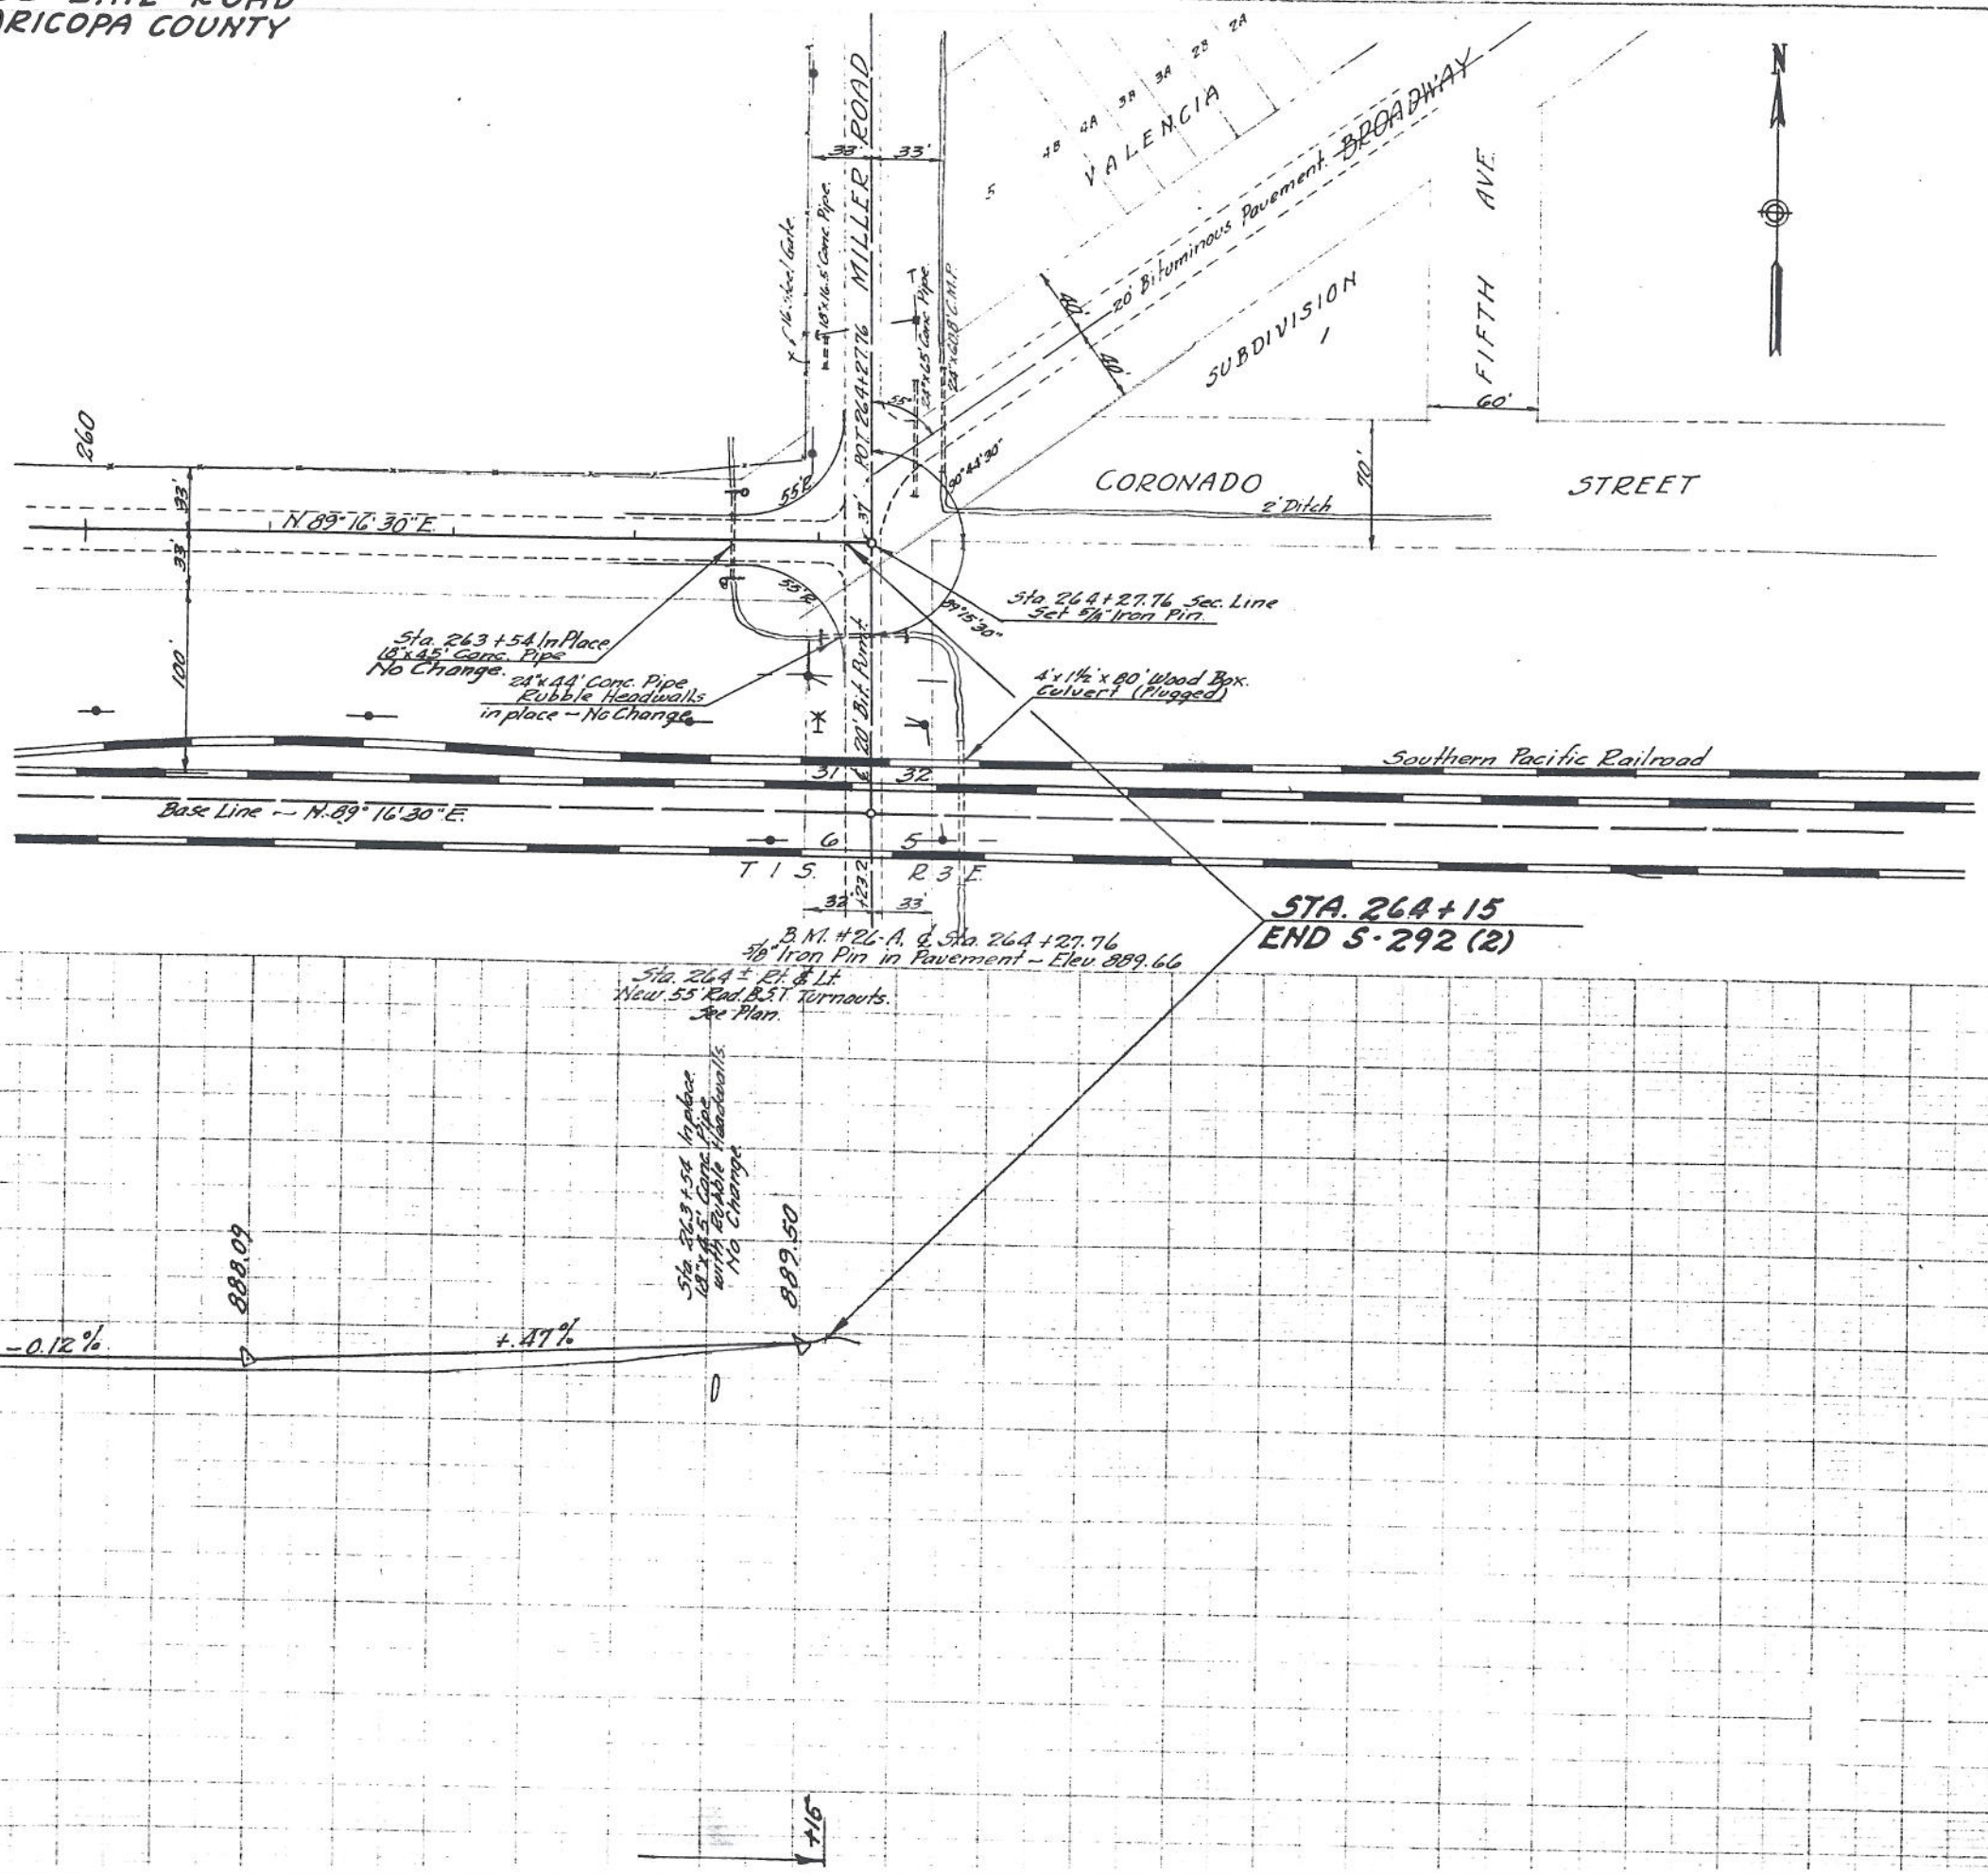
REDUCED SIZE
DO NOT SCALE