RESULT OF SURVEY

OF THE NORTH 40' OF THE WEST 234' OF THE SOUTH HALF OF THE NORTHWEST QUARTER OF THE SOUTHWEST QUARTER OF SECTION 14 T4N, R4E, EXCEPT THE NORTH 500 FEET THEREOF

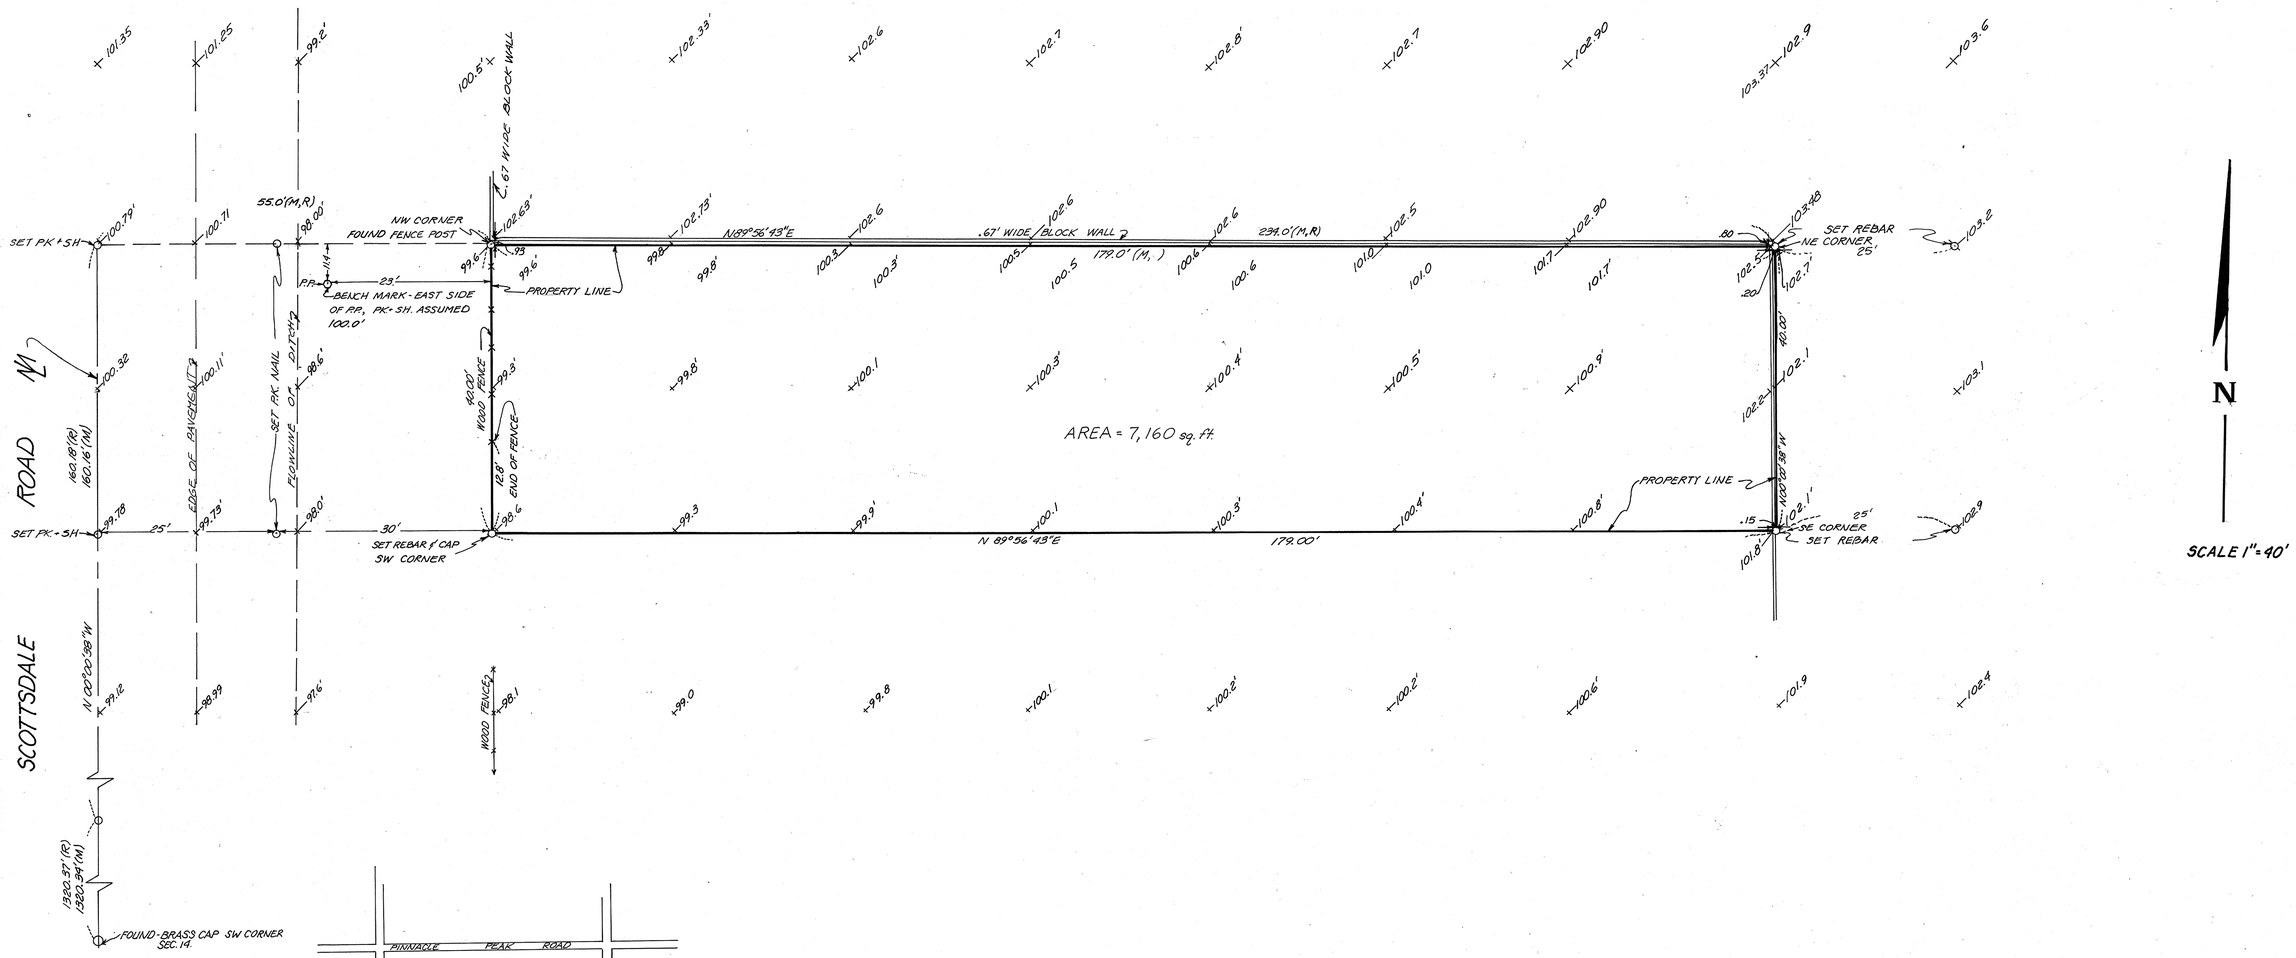

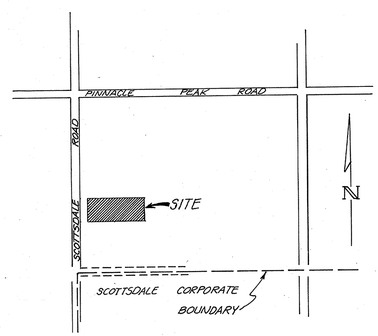

VICINITY MAP
NO SCALE

MINIMUM FINISH FLOOR 99.8

(M) - MEASURED DISTANCE
(R) - RECORDED DISTANCE
M - MEASURED LINE
+0.54 - ELEVATION

LEGEND

DIN # 51501-1

REGISTERED LAND SURVEYOR
CERTIFICATE NO. 12215
JEFFREY LYNN ANDREWS
DATE SIGNED 4/23/81
Arizona U.S.A.

J. L. ANDREWS and ASSOCIATES
6747 N. BLACK CANYON PHOENIX ARIZ. 85015
P.O. BOX 35161 PH. 242-6229

PREPARED FOR
TOM ADAM REALTY
7313 6 AVE.
SCOTTSDALE, AZ. 85257

SCALE: 1"=10'	DRAWING NO. 81-34
DATE: 4-23-81	DRAWN BY: K.E.O.

A3-035