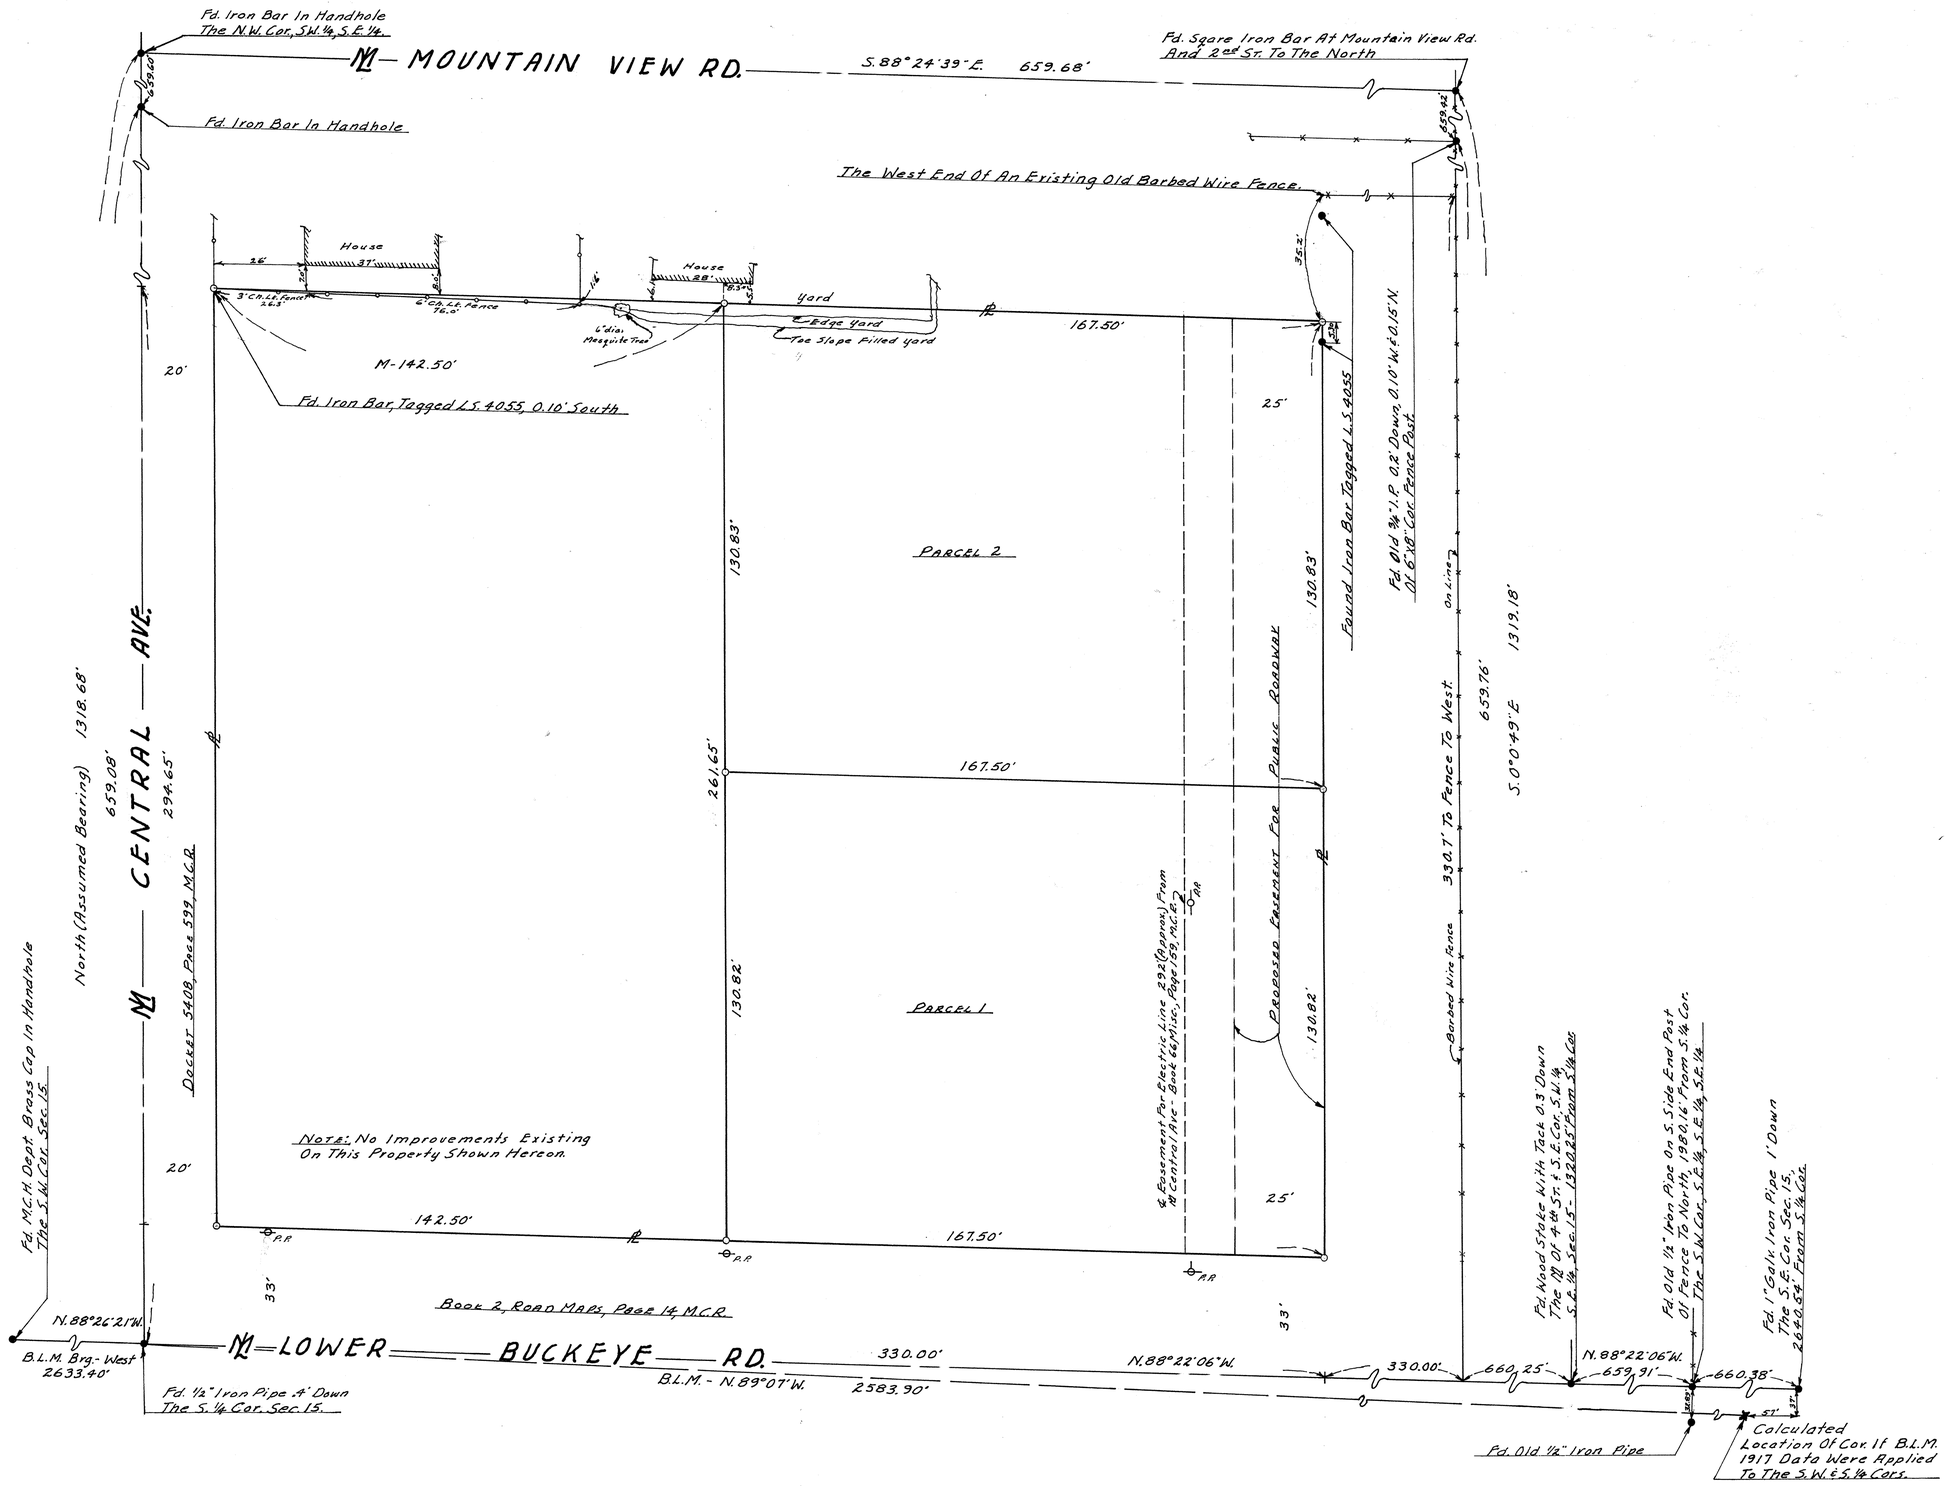

REPORT OF SURVEY FOR PEARL A. SULLINGER

1317 S. CENTRAL, AVONDALE, ARIZONA
OF THE S. 294.65' OF THE W. 330.00' OF THE S.W. 1/4, S.E. 1/4, SEC. 15, T. 1 N., R. 1 W., G. & S. R. B. & M., MARICOPA COUNTY, ARIZONA, AS DESCRIBED IN DOCKET 2033, PAGE 304, MARICOPA COUNTY REC.

N

Scale 1" = 20'

LEGEND
○ 1/2" dia. Iron Pipe Set This Survey
—○— Existing Power Pole
M.C.R. - Maricopa County, Arizona Records.

NOTE: The Boundary Of The Sullinger Property Was Laid Out Employing Temperature And Tension Corrections To Measurements. The Adjusted Boundary Of The West 660' Of The S.W. 1/4, S.E. 1/4, Sec. 15 Shown Hereon Was Done Using Ordinary Field Methods For Investigating The Pattern Of Ownership On The Ground.

NOTE: The Information Shown Hereon, Together With Further Study Of The Established Pattern In The S.E. 1/4, Sec. 15, By Field Investigation And The Study Of Maps And Section Corner Tie Information On File In This Office, Lead Me To The Considered Opinion The South Line Of The S.E. 1/4, Sec. 15 Shown Hereon Fits, Within Reason, Said Established Pattern. The Data From The Official Plat Of Resurvey Of Part Of T. 1 N., R. 1 W., G. & S. R. B. & M. On File In The Office Of The U.S. Bureau Of Land Management, Phoenix, Arizona, Approved Sept. 19, 1917, Shown Hereon As B.L.M. Data, Would Seriously Conflict With Said Pattern. The Corners Designated As Such On The South Line Of The S.E. 1/4 Hereon Are Therefor Accepted By Me As Described.

CERTIFICATION: This Will Certify That The Field And Office Work Shown Hereon Was Done By Me During March And April, 1967.

Eugene V. Kelley

EUGENE V. KELLEY
Registered Professional Engineer
Arizona, U.S.A.

DIN# 54817

ARIZONA SURVEYING SERVICE
1114 N. 7th St. PHOENIX ARIZONA
DRAWING No. - L-67-478