Tabulation of As-Built Gutter Flow-Line Elevations
Stationed to Northwest Along Grand Ave from 0+00 as Shown.

0+30 = 1138.64'	0+77 = 1138.53'	1+12 = 1138.57
0+48 = 38.63	0+92 = 38.60'	1+30 = 1138.57
0+62 = 38.59'	1+07 = 38.60	1+50 = 38.51

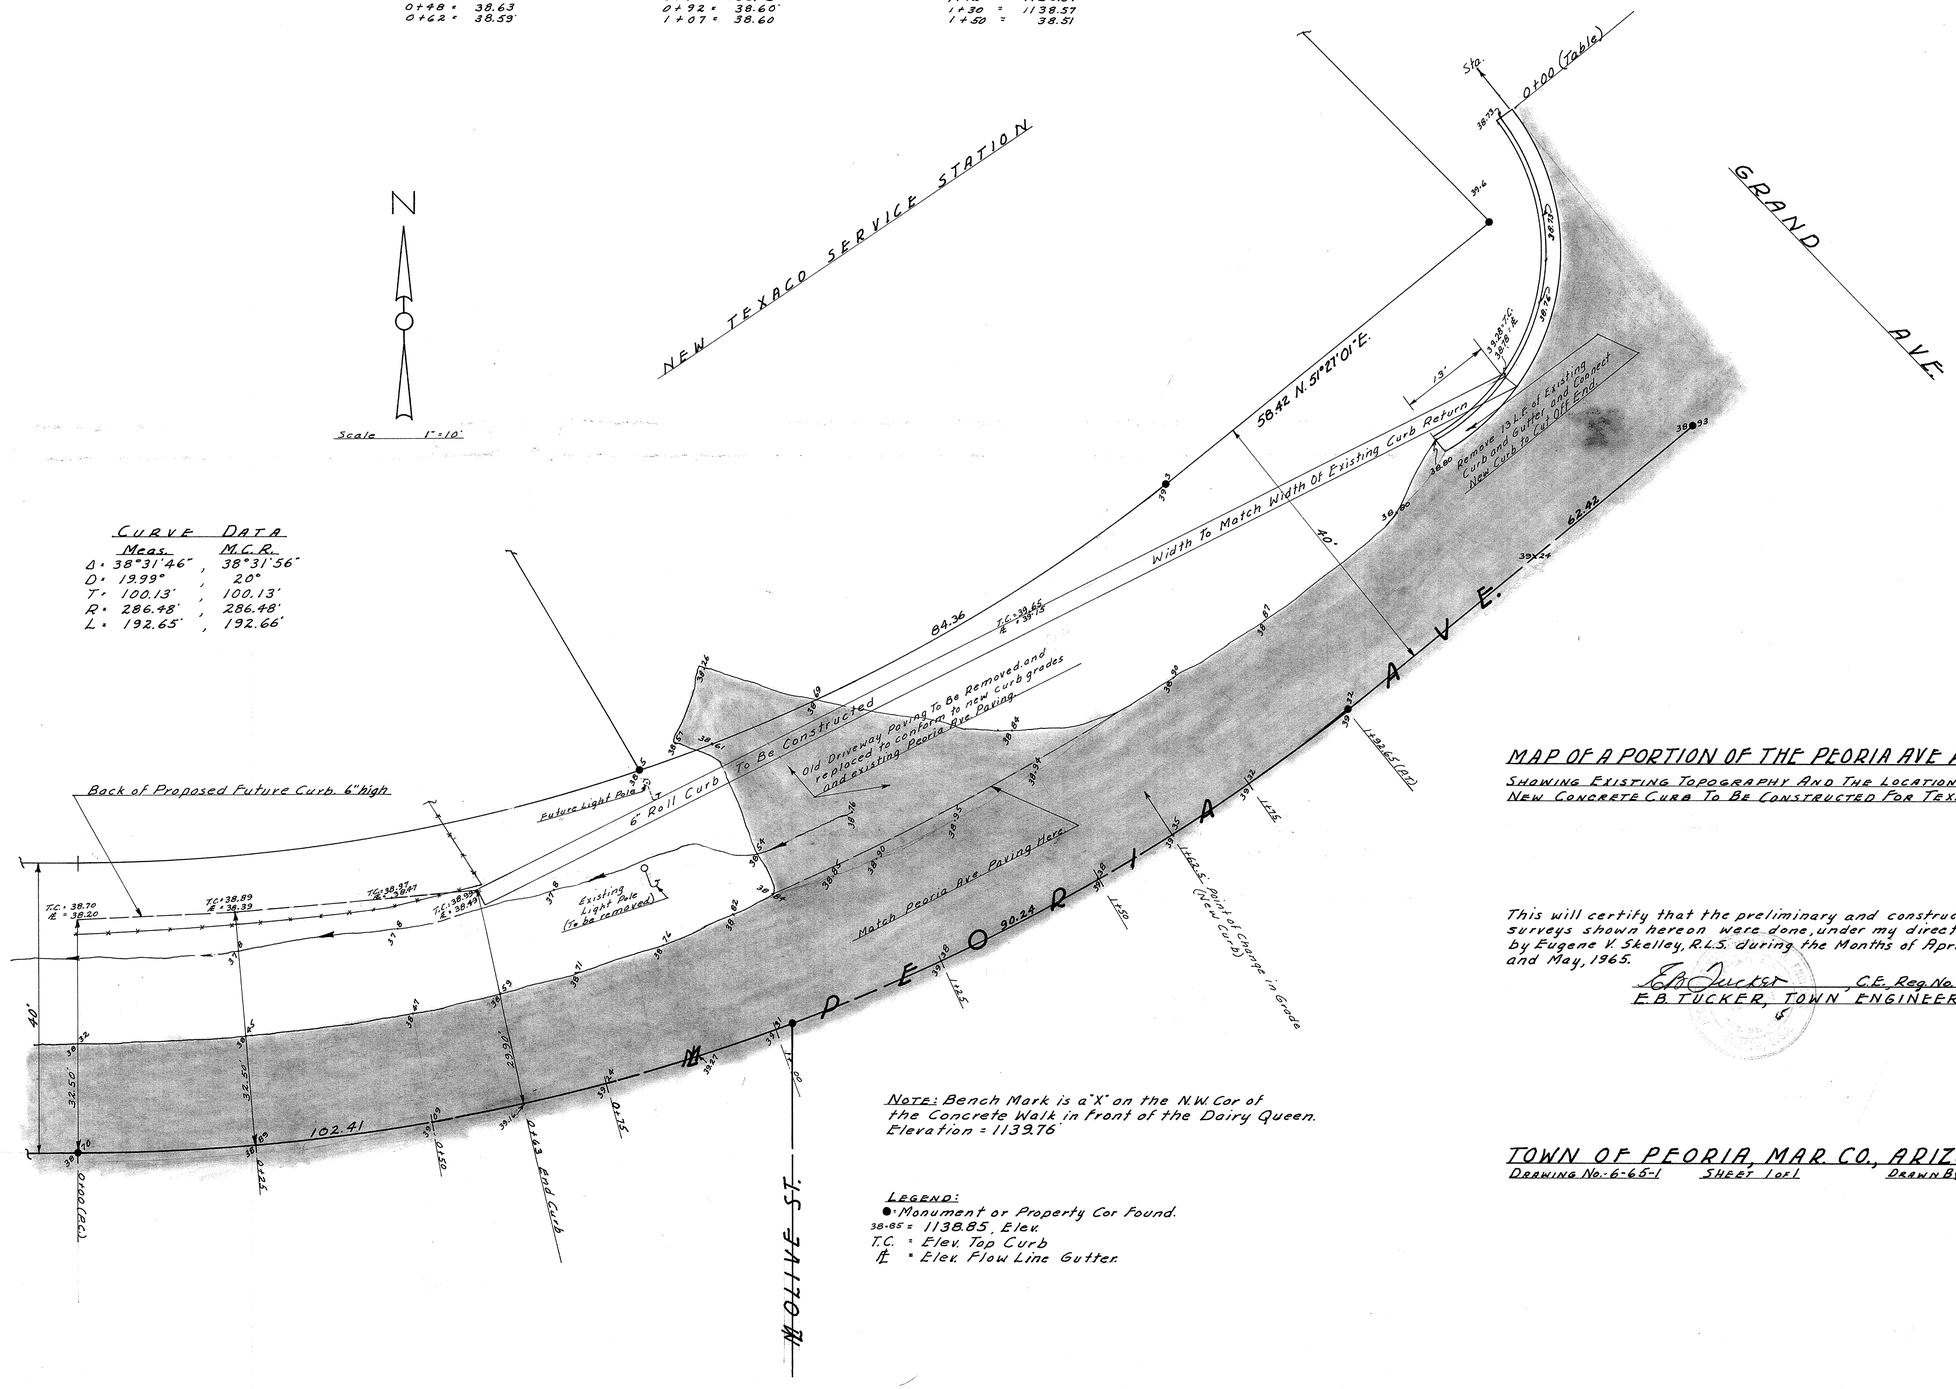

Curve Data

	Meas.	M.C.R.
Δ =	38°31'46" ,	38°31'56"
D =	19.99° ,	20°
T =	100.13' ,	100.13'
R =	286.48' ,	286.48'
L =	192.65' ,	192.66'

Note: Bench Mark is a "X" on the N.W. Cor of the Concrete Walk in front of the Dairy Queen. Elevation = 1139.76'

Legend:
- ● = Monument or Property Cor Found.
- 38.85 = 1138.85, Elev.
- T.C. = Elev. Top Curb
- F.L. = Elev. Flow Line Gutter.

MAP OF A PORTION OF THE PEORIA AVE R/W.

Showing Existing Topography And The Location Of A New Concrete Curb To Be Constructed For Texaco Co.

This will certify that the preliminary and construction surveys shown hereon were done, under my direction, by Eugene V. Skelley, R.L.S. during the Months of April and May, 1965.

E.B. Tucker, C.E. Reg. No. 792
E.B. TUCKER, TOWN ENGINEER

TOWN OF PEORIA, MAR. CO., ARIZONA

Drawing No. 6-65-1 Sheet 1 of 1 Drawn By - E.K.S.

DIN# 54820

EP-65-413