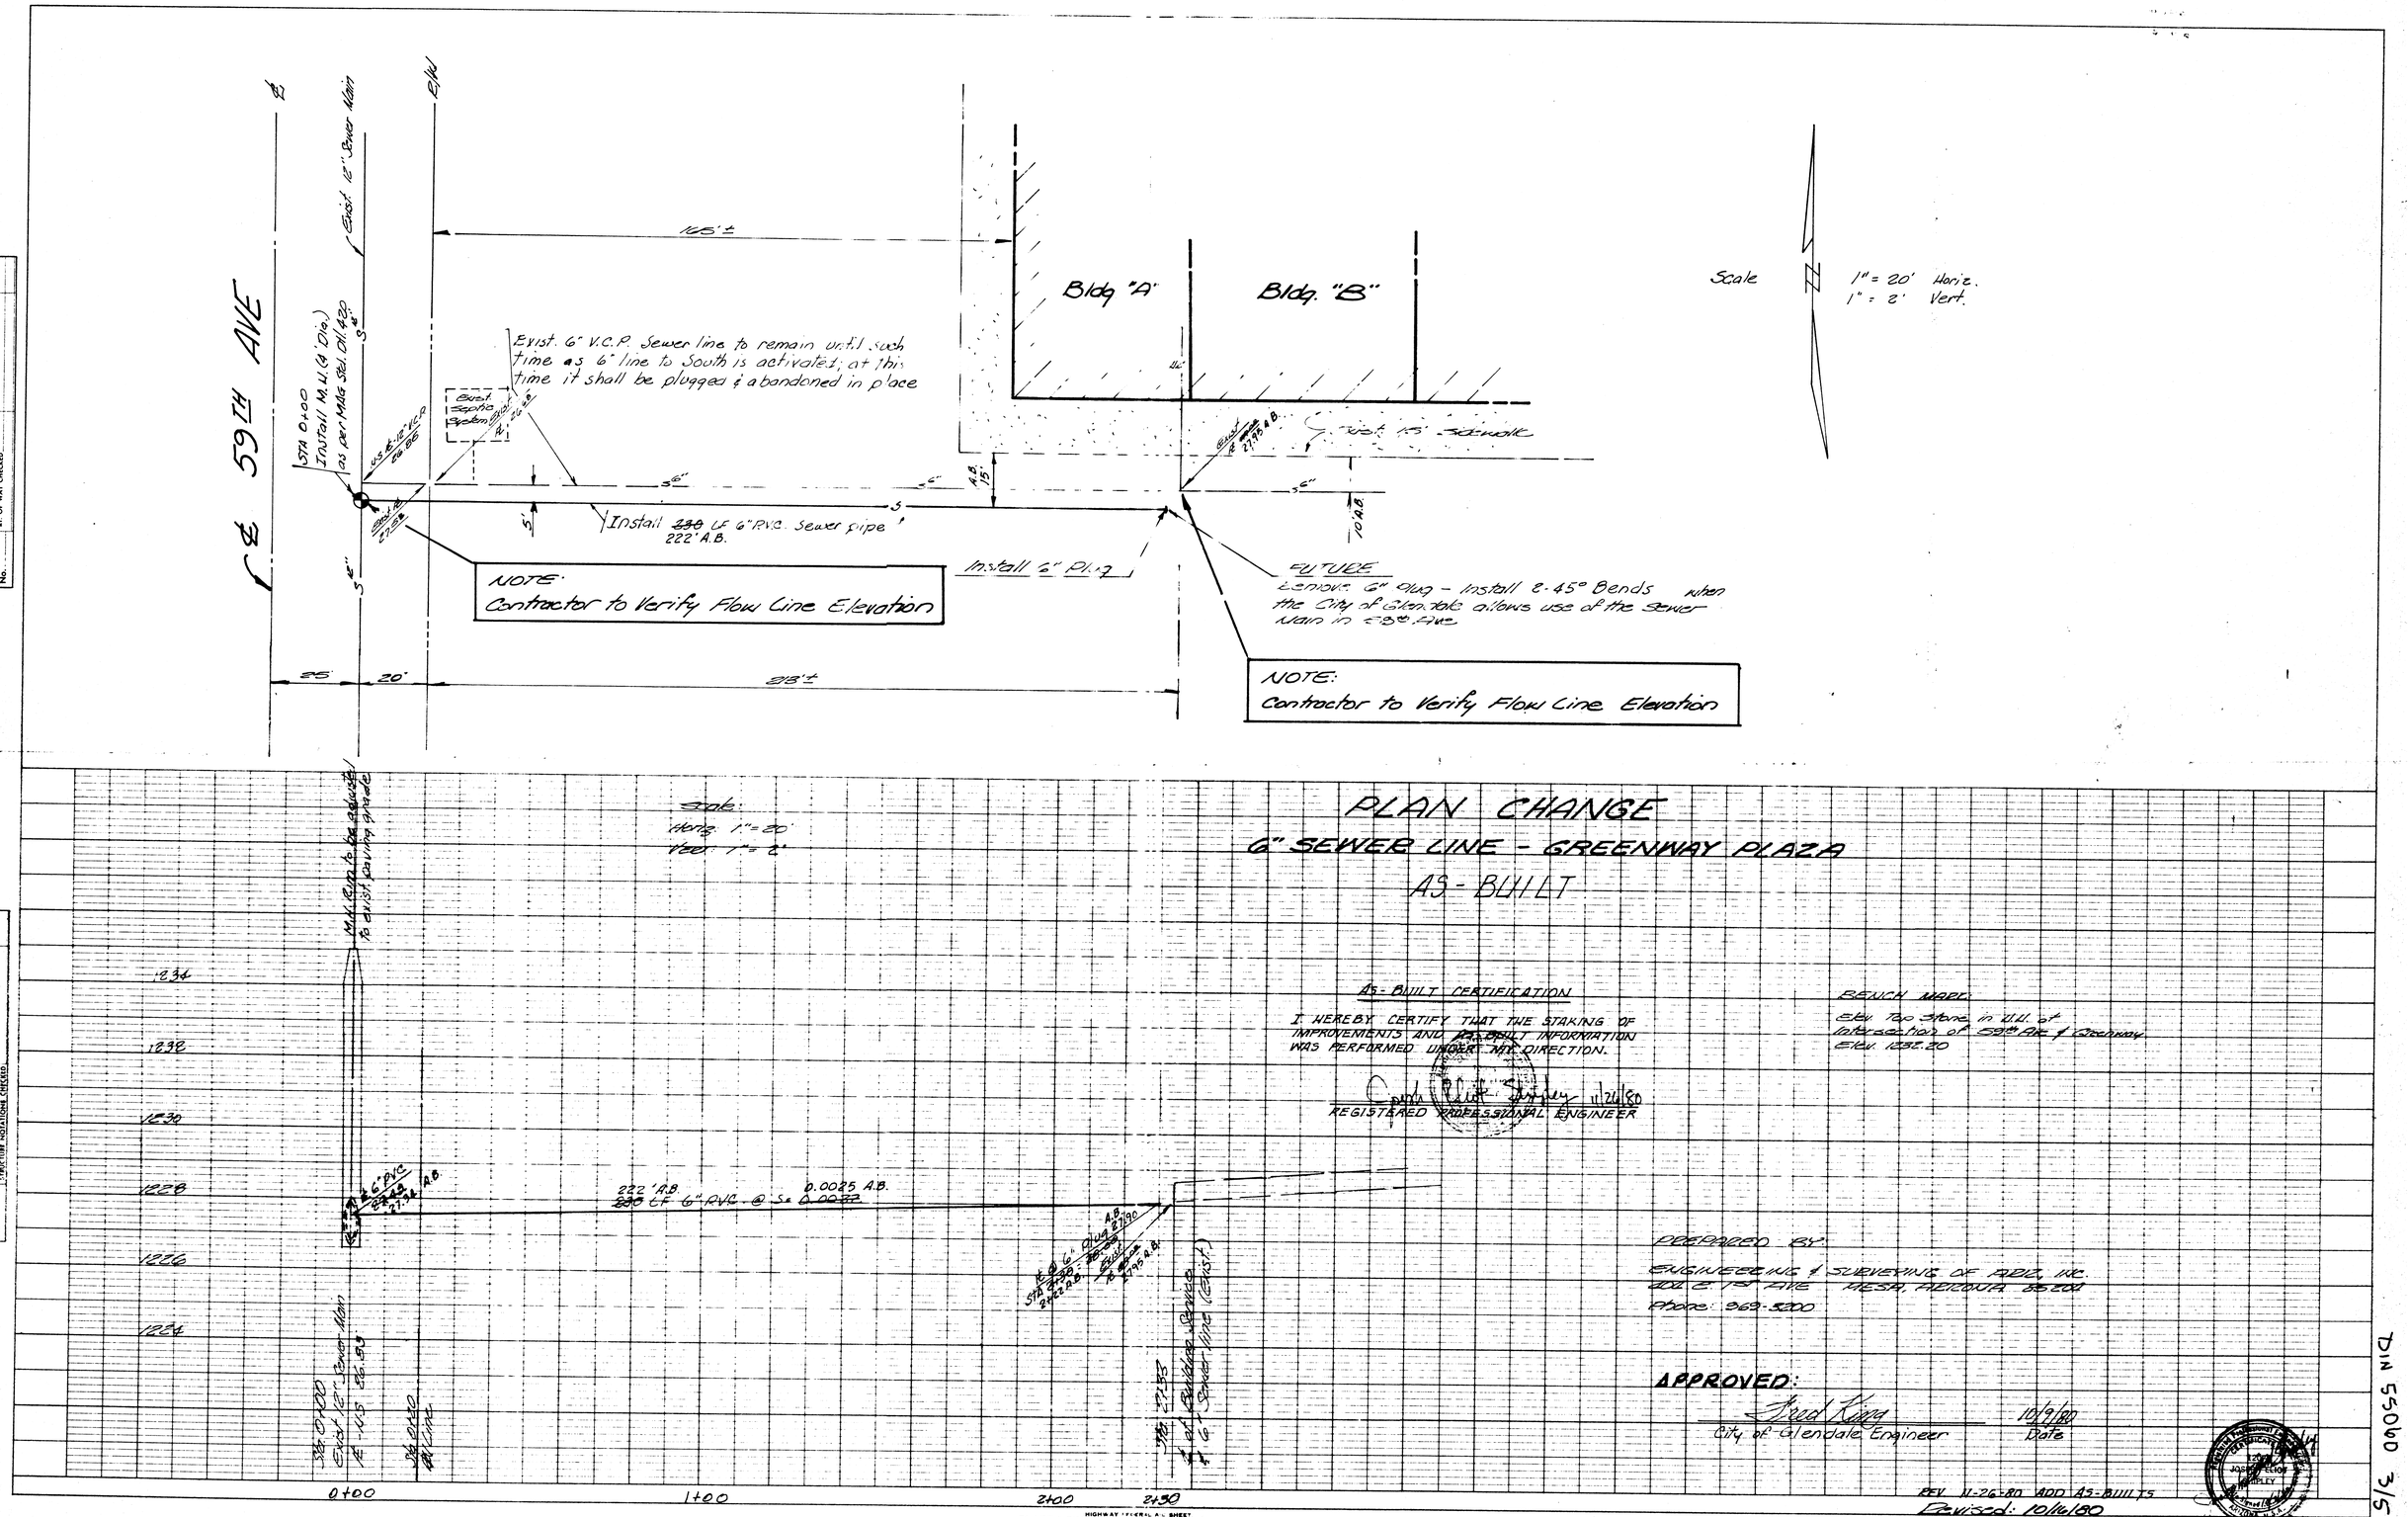

PLAN CHANGE

6" SEWER LINE - GREENWAY PLAZA

AS-BUILT

AS-BUILT CERTIFICATION

I HEREBY CERTIFY THAT THE STAKING OF IMPROVEMENTS AND AS-BUILT INFORMATION WAS PERFORMED UNDER MY DIRECTION.

[signature] 11/26/80

REGISTERED PROFESSIONAL ENGINEER

BENCH MARK:

Elev. Top Stone in U.H. at Intersection of 59th Ave & Greenway
Elev. 1232.20

PREPARED BY:

ENGINEERING & SURVEYING OF ARIZ. INC.
404 E. 1ST AVE MESA, ARIZONA 85204
Phone: 969-3200

APPROVED:

[signature] 10/9/80

City of Glendale Engineer — Date

REV. 11-26-80 ADD AS-BUILTS

Revised: 10/16/80

PLATE 1-SINGLE PLAN AND PROFILE-FULL LINE

DIN 55060 3/5