LOCATION MAP

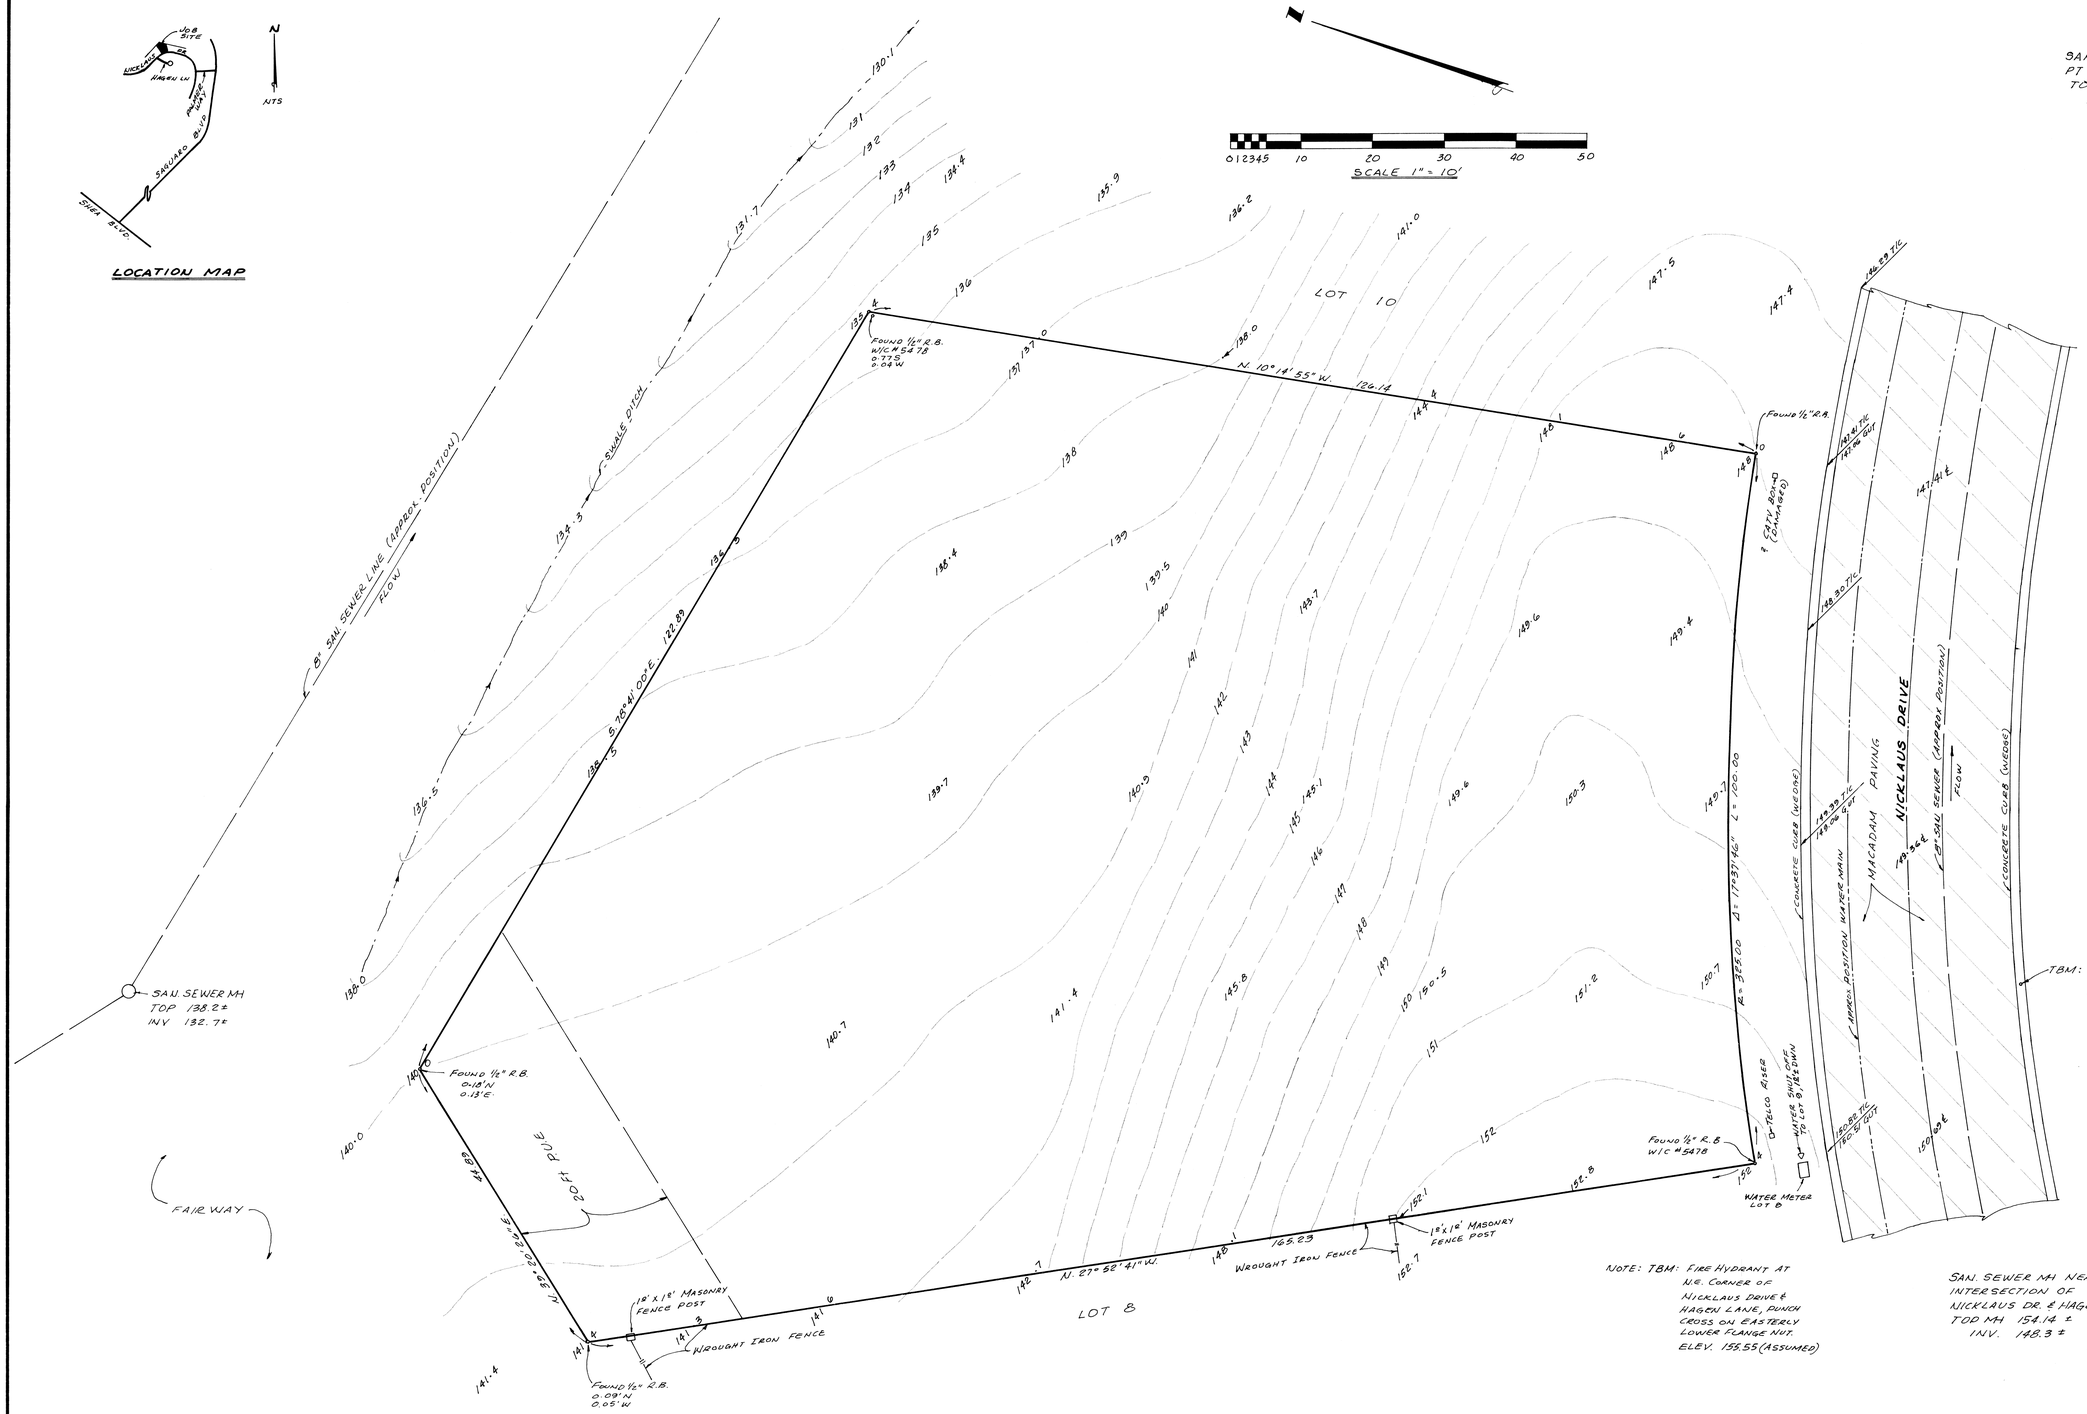

LEGEND

T/C	TOP OF CURB
GUT	GUTTER
MH	SANITARY SEWER MANHOLE
CATV	CABLE TV
TELCO	U.S. WEST TELEPHONE
150^{B}	EXISTING GRADE
T.B.M.	TEMPORARY BENCH MARK
P.U.E	PUBLIC UTILITY EASEMENT

NOTES:

1. UTILITIES SHOWN HEREON WERE TAKEN INPART FROM VARIOUS "AS BUILT" RECORDS AND OTHER RECORDS AND THERE IS NO GUARANTEE BY US THAT THEY ARE IN THE LOCATION INDICATED BY THESE RECORDS. (CALL BLUE STAKE PRIOR TO ANY CONSTRUCTION IN THE AREA)

2. ELECTRIC TRANSFORMER IS LOCATE AT THE S.E. CORNER OF LOT 10, BLOCK 2.

BOUNDARY & TOPOGRAPHICAL SURVEY OF

LOT 9, BLOCK 2, OF FOUNTAIN HILLS ARIZONA FINAL PLAT NO. 401-B AS RECORDED IN BOOK 155 OF MAPS, PAGE 12, MARICOPA COUNTY RECORDERS OFFICE.

FOUNTAIN HILLS, ARIZONA

NW Sec 26 T3N R6E

REGISTERED LAND SURVEYOR CERTIFICATE NO. 10172 CHARLES G. MELCHING Date Signed 1-24-92 ARIZONA, U.S.A.

CHARLES G. MELCHING RLS
Consulting Land Surveyor
2557 E. Encanto
Mesa, Arizona 85213
(602) 833-2007

DIN 56125

Job No 92001 1-24-92