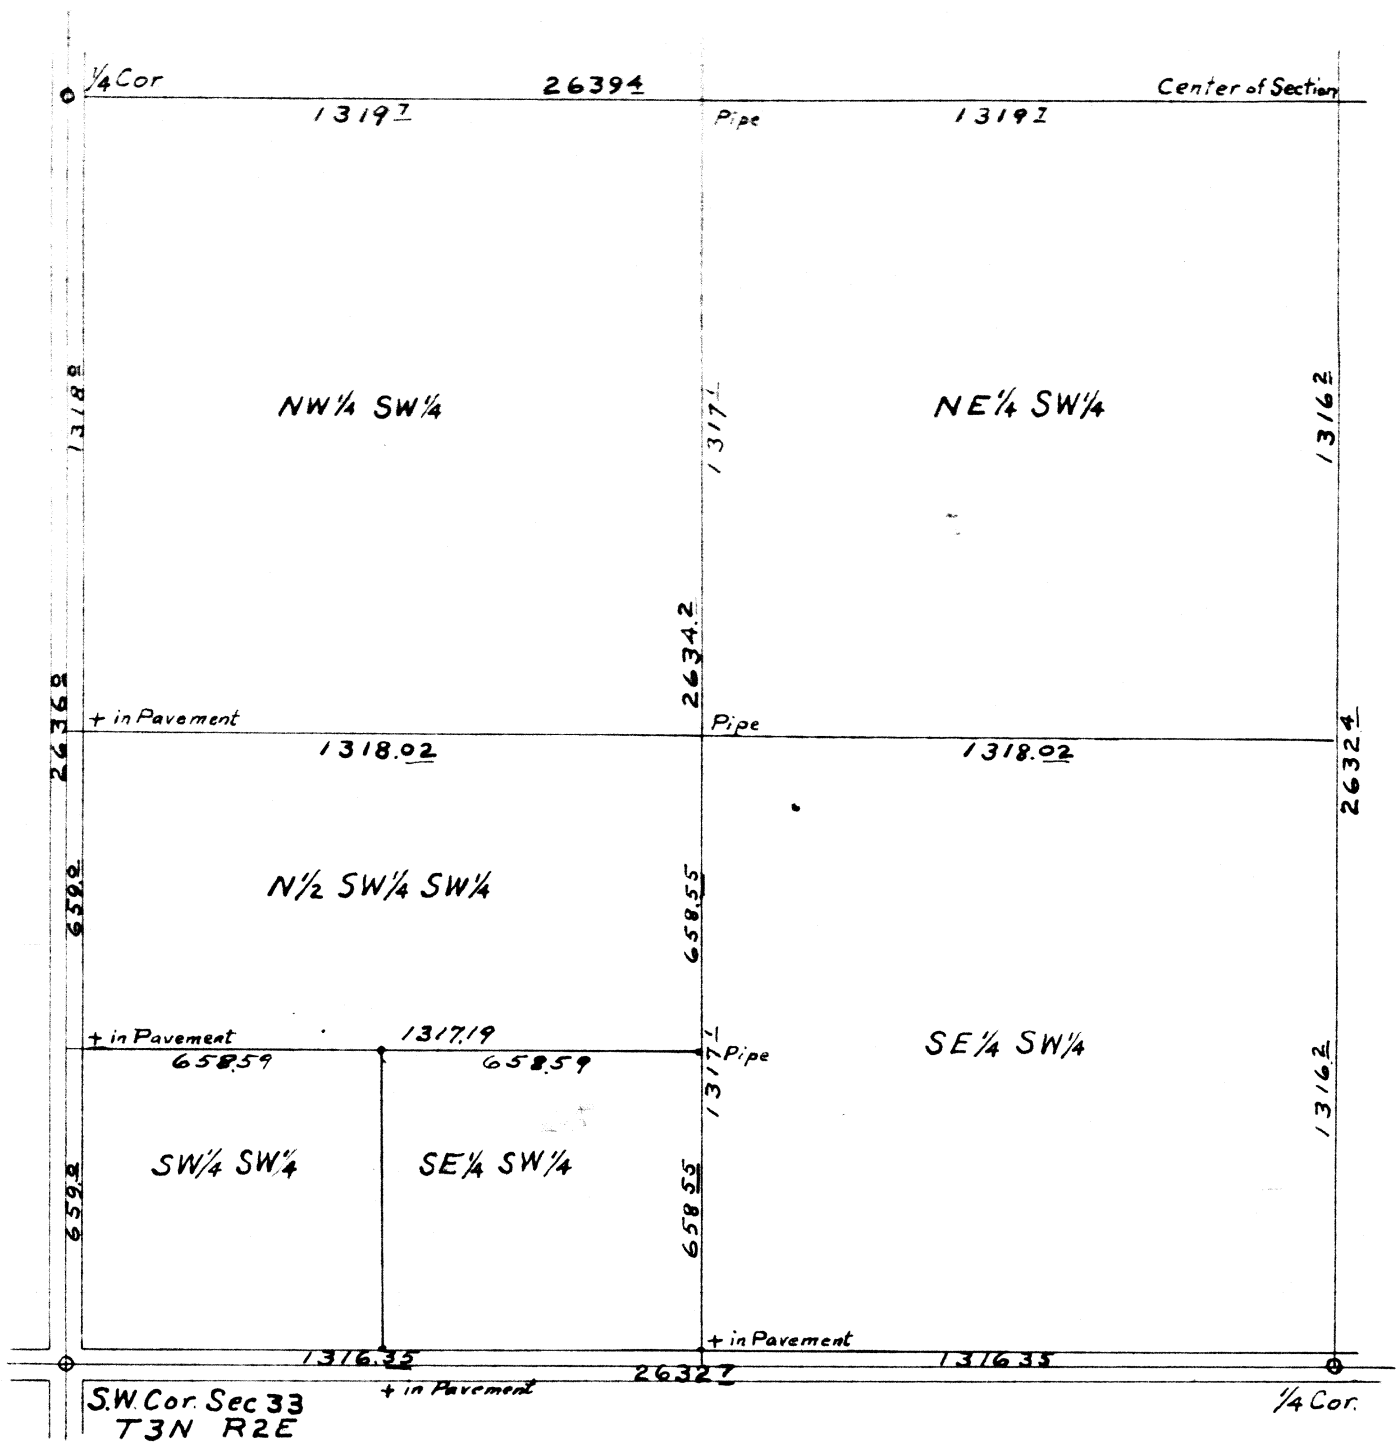

S.W. QUARTER SECTION 33
TP. 3 N. RG. 2 E.
G. & S. R. B. & M.

Surveyed & drawn by ~~W. H. Bartlett~~.

March 1924.

Scale 1" = 400'.

Amended to Dec. 1936 ~~W. H. B.~~

DIN # 56418-1/1
APLS

REGISTERED LAND SURVEYOR
CERTIFICATE EXPIRES
No. 8
BARTLETT
DEC 31 1937
ARIZONA, U.S.A.