REPORT OF SURVEY

For
The SIERRA NEGRO RANCH
Star Rte 304
Buckeye, Arizona

Describing The Sec.& 1/4 Sec. Cors. Of Sec. 32, T.2 N., R.6 W., G.&S.R.B.&M. & The Location Of Adjacent Fences In Sec. 32.

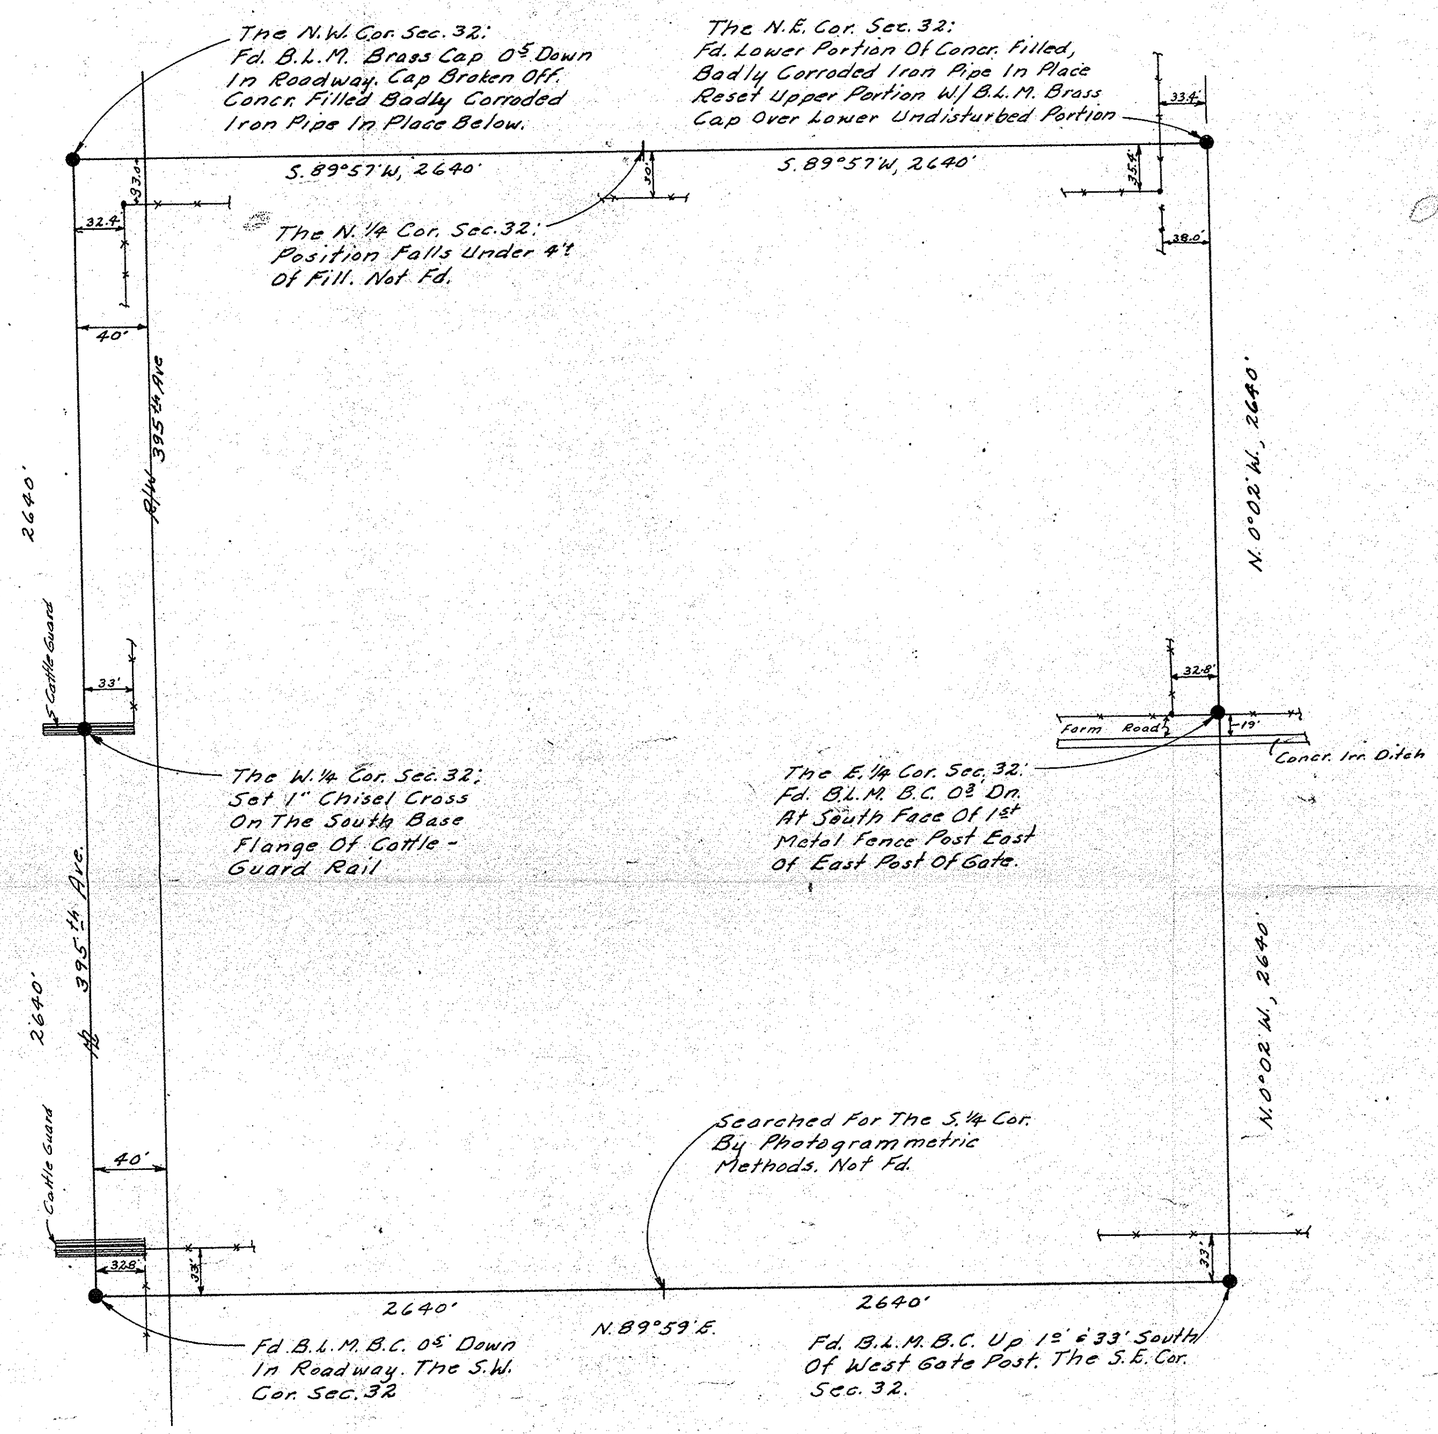

N

Scale: None

LEGEND

- ● = Monument Found
- ● = Iron Pipe or Iron Bar Found
- ○ = 1/2" I.D. Iron Pipe Tagged L.S. 1681 Set This Survey
- R = Data From Maricopa County Records
- CR = Calculated From R
- M = Measured In Field
- CM = Calculated From M
- = Wire or Wood Fence
- = Chain Link Fence
- = Block or Stone Wall

Ties to the S.W. Cor. Sec. 32

S.W. to Nail and Tin in Power Pole - 43.6'
S.S.W. to Nail and Tin in Guy Pole - 97.70'

Ties to the N.W. Cor. Sec. 32

S.E. to Nail and Tin in Fence Cor. Post - 46.33'
N.E. to 1/2" square Iron Bar - 45.90'

Ties to the E. 1/4 Cor.

S.W. to X chiseled in N. Bank of Concr. Irr. Ditch - 28.38'
S. to X chiseled in N. Bank of Concr. Irr. Ditch - 19.18'
S.E. to X chiseled in N. Bank of Concr. Irr. Ditch - 27.08'

Ties to the N.E. Cor.

Visible - 0.5' Above Ground Related to Fences as Shown.

CERTIFICATION: This will certify that the survey shown hereon was done under my supervision during the month of Nov. & Dec. 15, 1972

Eugene P. Kelly

Note: Bearings And Distances Between Corners Shown Hereon Are B.L.M. Data.

ARIZONA SURVEYING SERVICE
5704 N. 27th AVENUE, PHOENIX, ARIZONA
Drawing No. L-72-11-738 - Phone: 277-3904

DIN# 56735-1/1
APLS