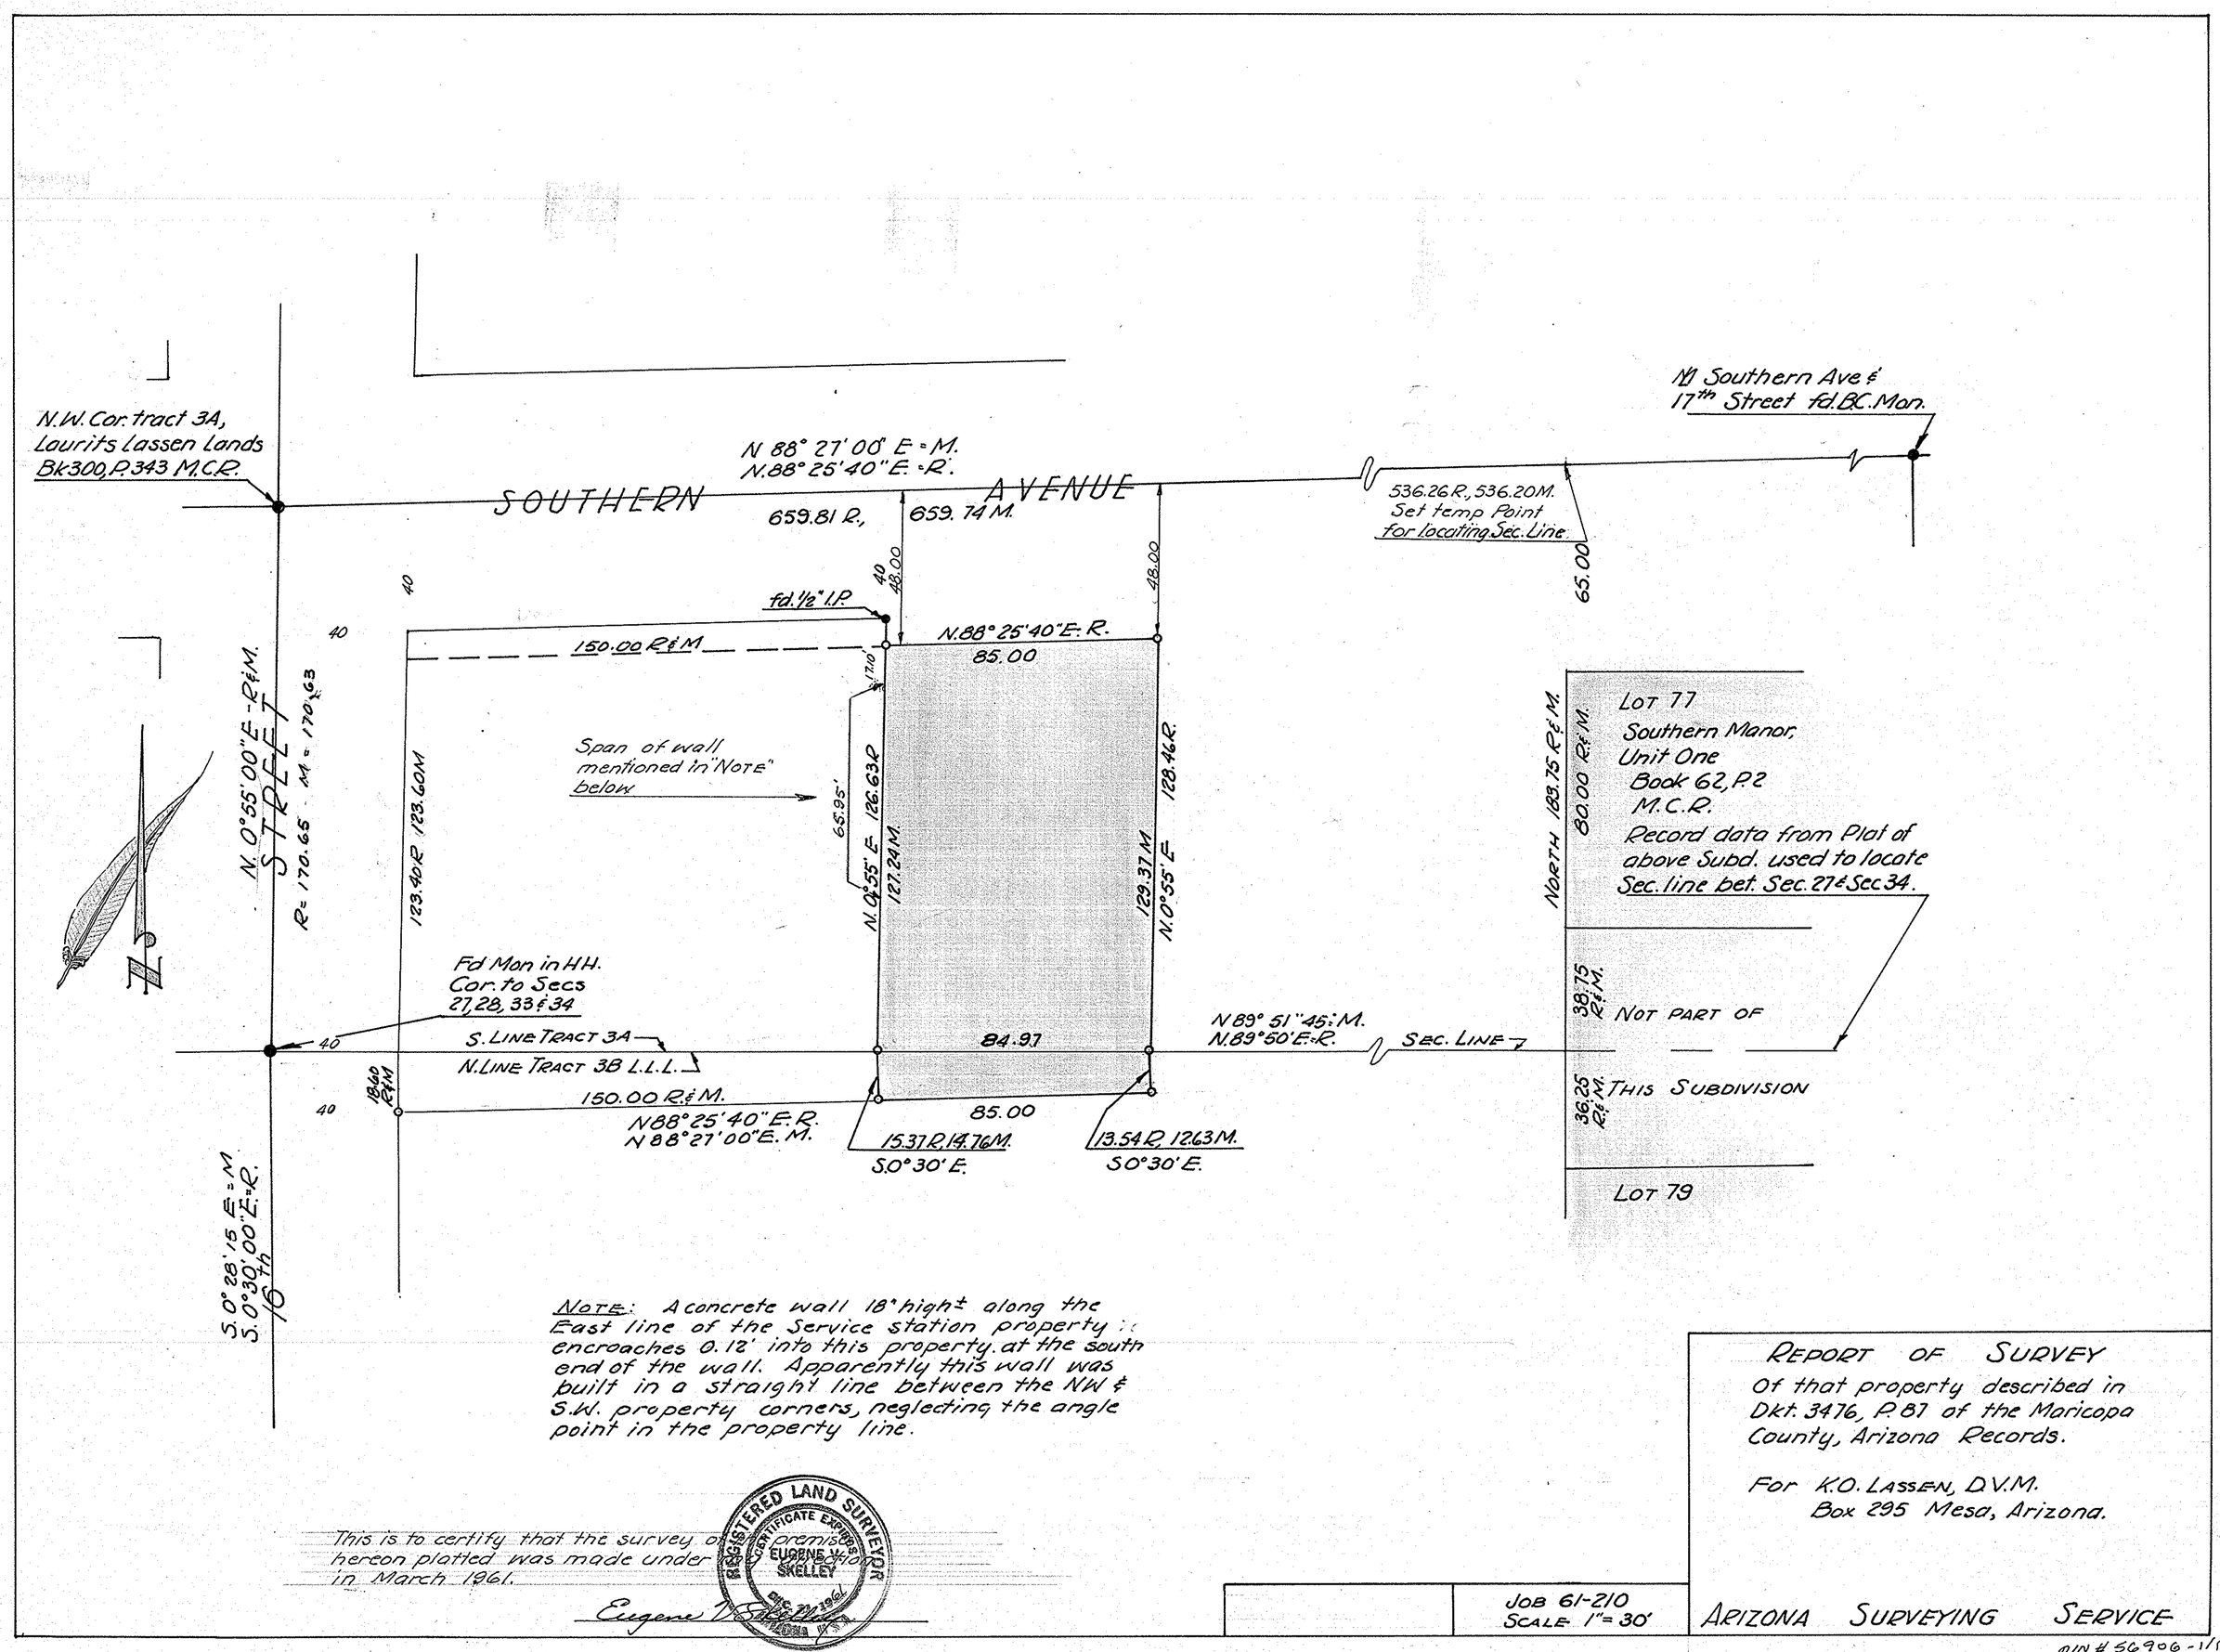

NOTE: A concrete wall 18" high± along the East line of the Service station property encroaches 0.12' into this property at the south end of the wall. Apparently this wall was built in a straight line between the NW & S.W. property corners, neglecting the angle point in the property line.

This is to certify that the survey of the premises hereon platted was made under my supervision in March 1961.

Eugene V. Skelley

REGISTERED LAND SURVEYOR — CERTIFICATE EXPIRES DEC. 31, 1961 — EUGENE V. SKELLEY — ARIZONA U.S.A.

REPORT OF SURVEY

Of that property described in Dkt. 3476, P. 87 of the Maricopa County, Arizona Records.

For K.O. LASSEN, D.V.M.
Box 295 Mesa, Arizona.

JOB 61-210
SCALE 1" = 30'

ARIZONA SURVEYING SERVICE

DIN # 56906-1/1
APLS