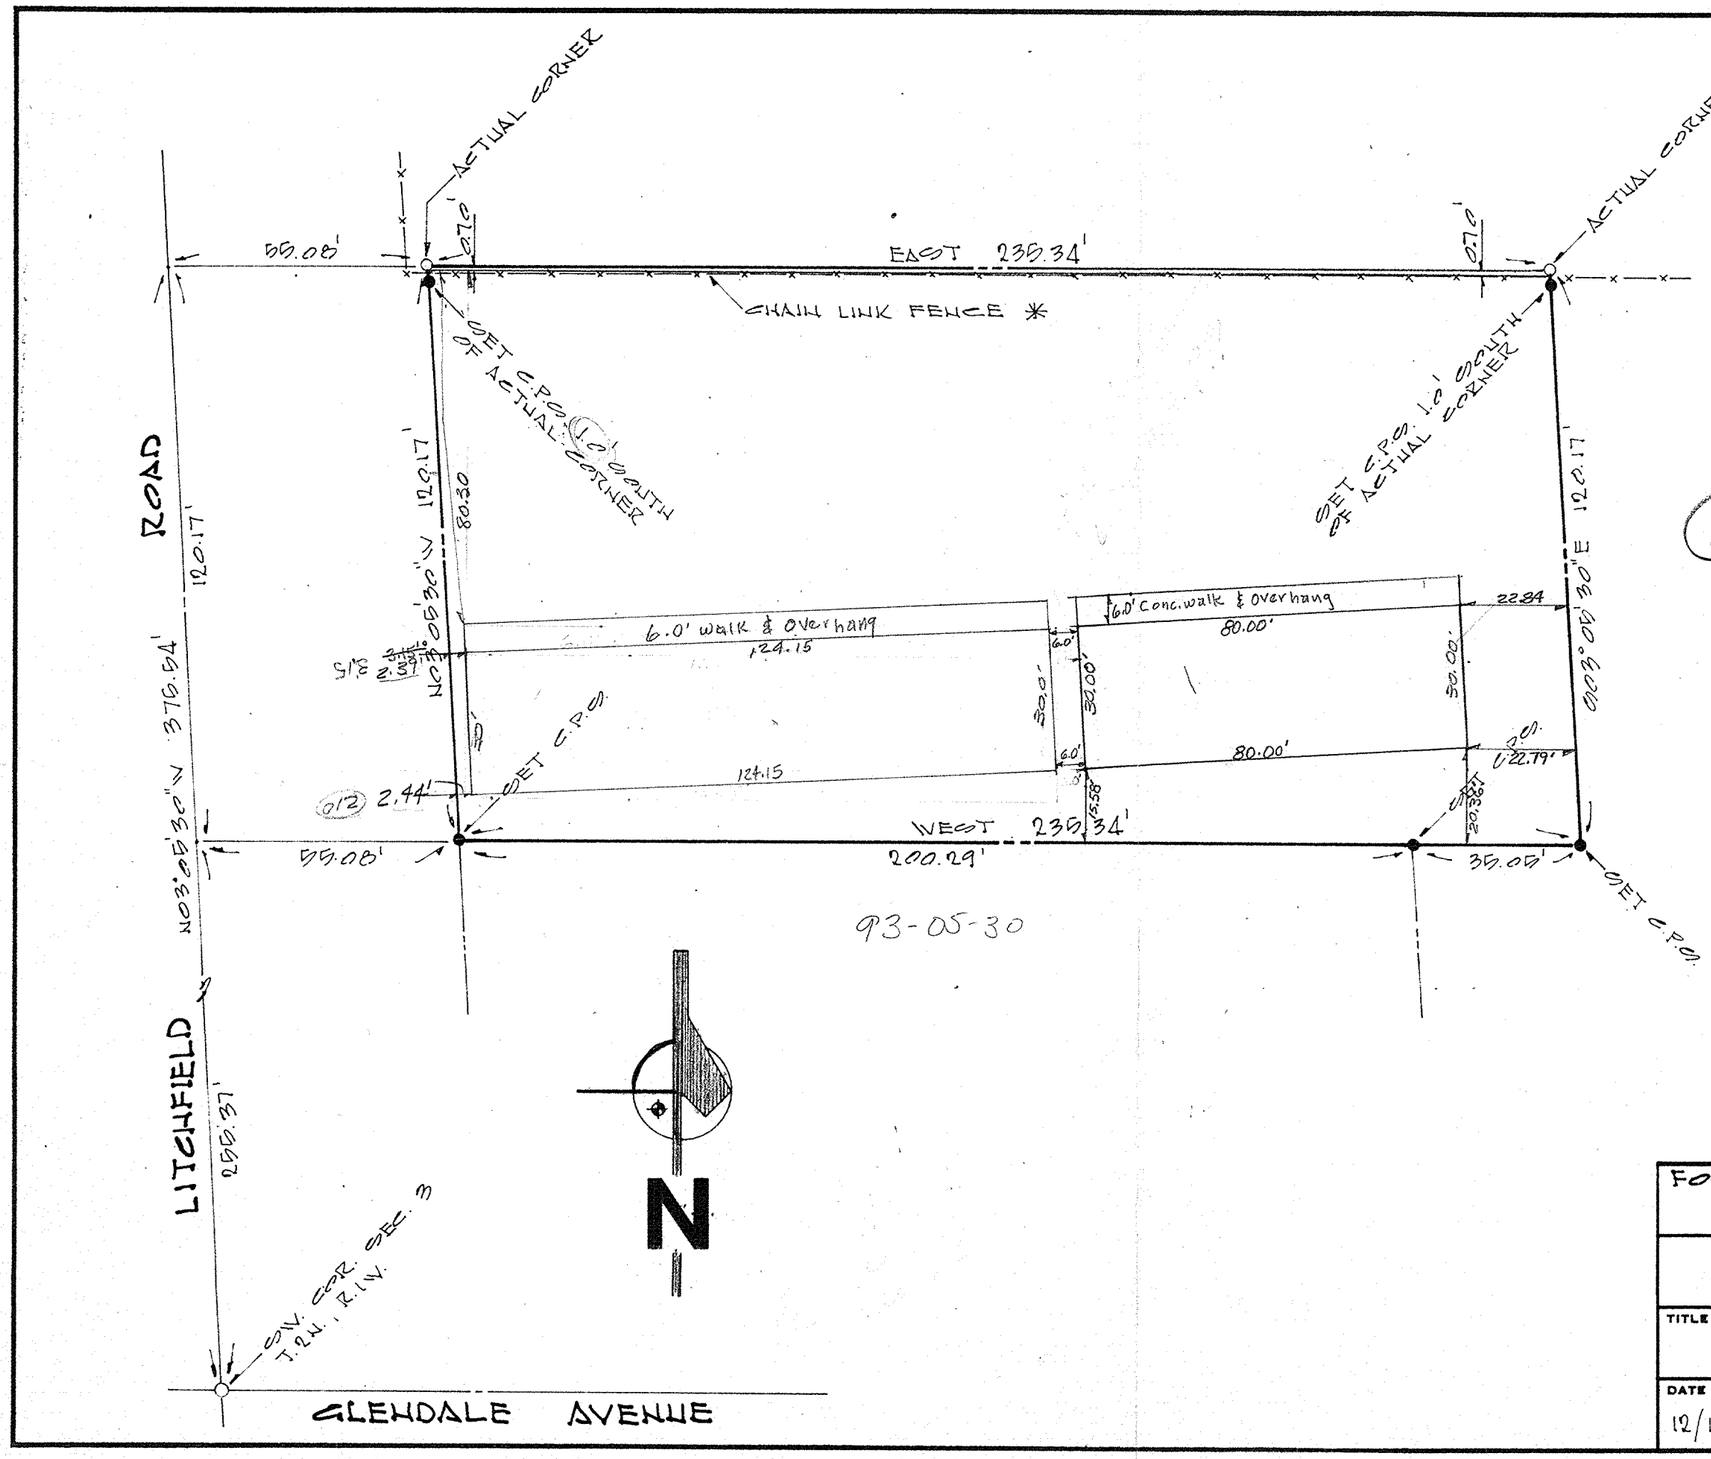

LEGAL DESCRIPTION

THE NORTH 120' OF THE SOUTH 375' OF THE WEST 355' OF THE SOUTH-WEST QUARTER OF SECTION 3, T.2N., R.1W., G.&S.R.B.&M., MARICOPA COUNTY, ARIZONA.
EXCEPT THE WEST 55' AND THE EAST 65'

C.P.S. - COTTON PICKER SPINDLE

OK.

CERTIFICATE

I CERTIFY BY MY SEAL & SIGNATURE HEREON THAT THE SURVEY ~~OF~~ Building location on THE PROPERTY HEREIN SHOWN WAS PERFORMED UNDER MY SUPERVISION DURING THE MONTH OF ~~DECEMBER~~ May, 1978.
~~ALL CORNERS WERE SET AS SHOWN. ENCROACHMENTS FOUND ARE INDICATED THUS *~~

Registered Professional Engineer (Civil) CERTIFICATE NO. 572 ROBERT ROLAND JOHNSON Date Signed 12-20-77 ARIZONA, U.S.A.

FOR BILL FULKERSON & BILL AMES		
	SCALE 1" = 30'	DRAWN BY [signature]
		APPROVED BY
TITLE RESULTS OF SURVEY		
DATE 12/19/77	DRAWING NUMBER 572-4 A	ASSOCIATED ENGINEERS Civil Consultants Phoenix Arizona

Drn # 57435 1/1