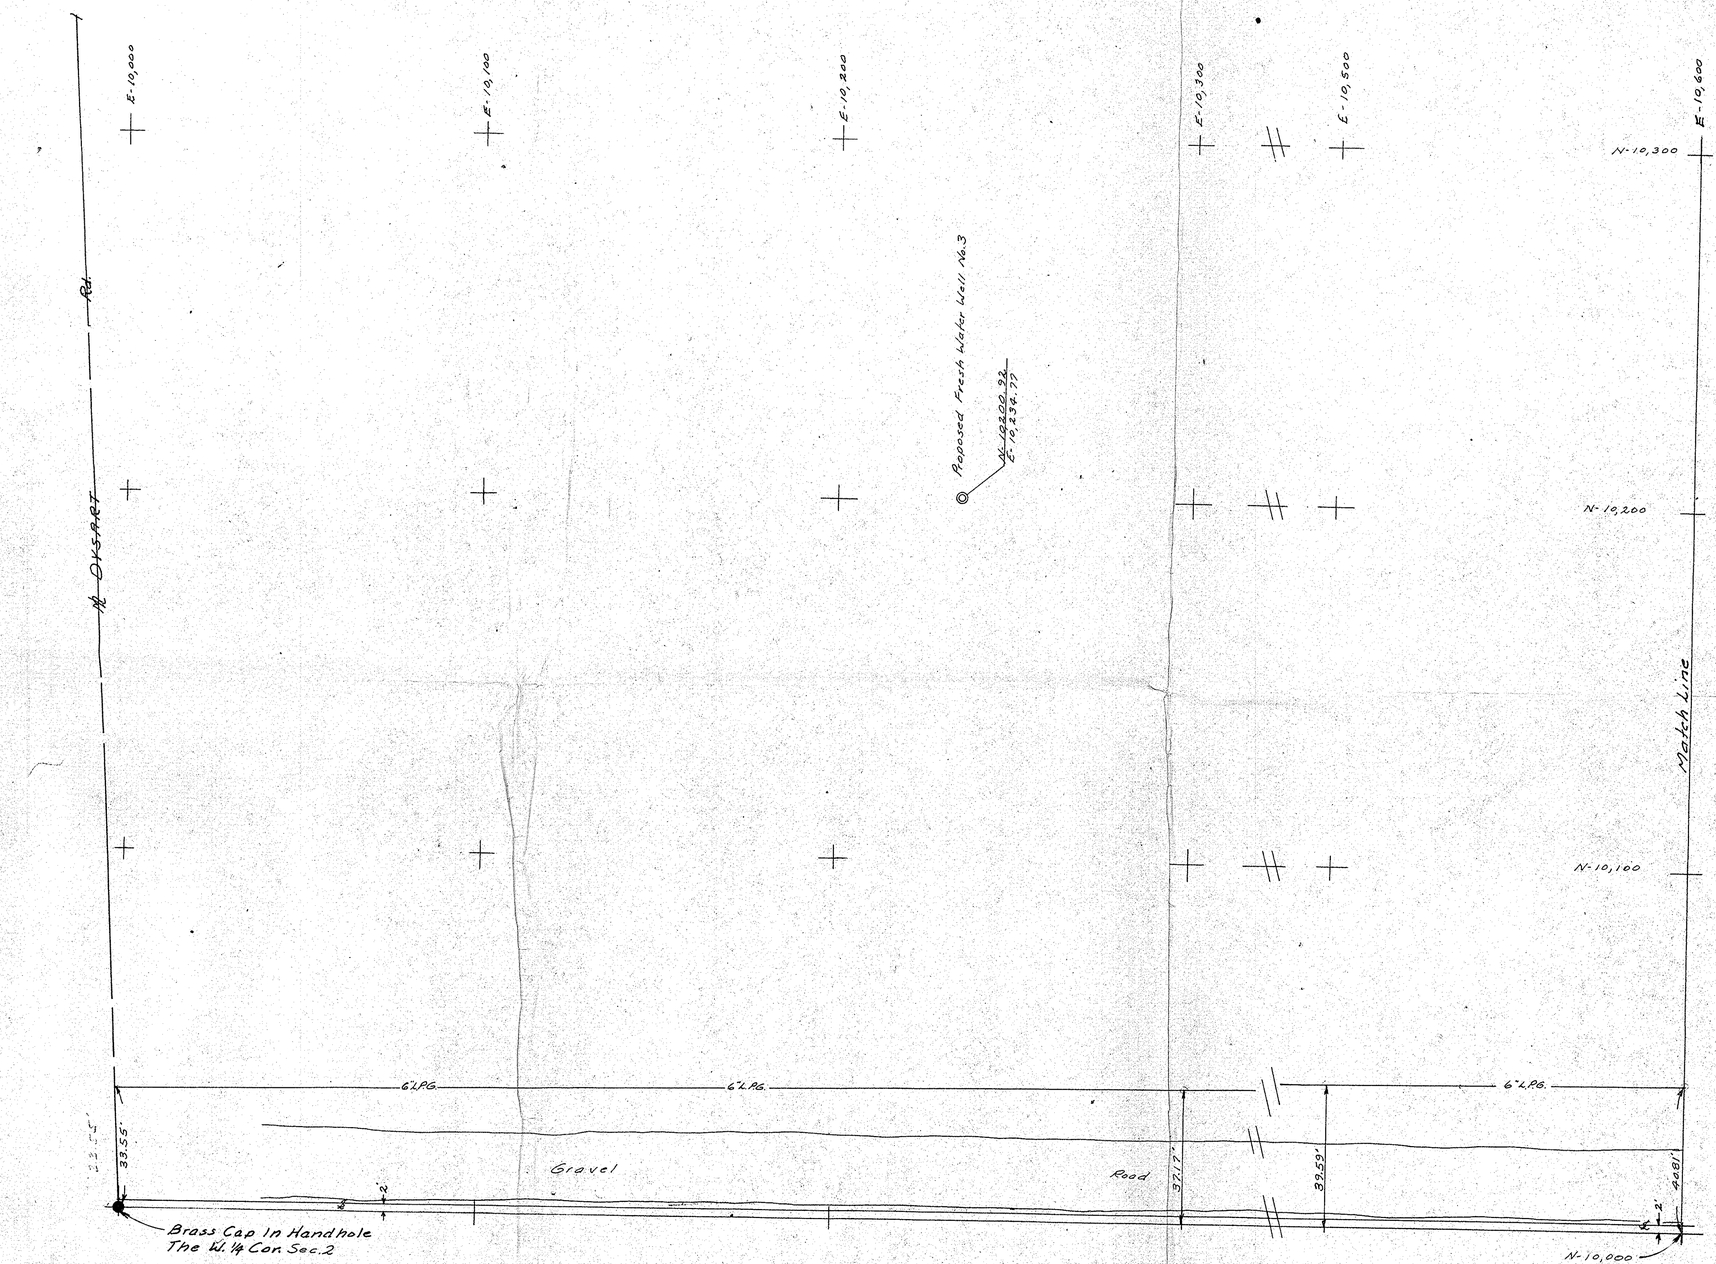

REPORT OF SURVEY

OF

A Portion of the S.W. 1/4, N.W. 1/4, Sec. 2, T. 2 N., R. 1 W., G. & S.R.B. & M., Maricopa County, Arizona - Showing Certain Existing and Proposed Installations.

FOR

FENIX & SCISSON, INC.
Engineers & Contractors
Tulsa, Oklahoma

N

Scale: 1" = 20'

LEGEND

- ● = Monument Found
- ● = Iron Pipe or Iron Bar Found
- ○ = 1/2" I.D. Iron Pipe Tagged L.S. 1681 Set This Survey
- R = Data From Maricopa County Records
- CR = Calculated From R
- M = Measured in Field
- CM = Calculated From M
- = Wire or Wood Fence
- = Chain Link Fence
- = Block or Stone Wall

Note: A Pipe Line Presently Under Construction Along The North Side Of The Gravel Road Is Not Located This Survey.

Note: Revised This Date To Add The Location Of A 6" Liquid Propane Line Based On As-Built Data Furnished By Coe & Van Loo, Cons. Engrs., Phx., Az.

Eugene V. Shelley 9/27/74

REGISTERED LAND SURVEYOR CERTIFICATE NO. 1681 EUGENE V. SHELLEY ARIZONA U.S.A.

CERTIFICATION: This will certify that the survey shown hereon was done under my supervision during the month of July, 1974

Eugene V. Shelley 7/30/74

REGISTERED LAND SURVEYOR CERTIFICATE NO. 1681 EUGENE V. SHELLEY ARIZONA U.S.A.

ARIZONA SURVEYING SERVICE
2802 W. Solano Dr., N.
Phoenix, Arizona Phone: 242-3609

Drawing No. L-74-6807

Sheet 3 of 3

DIN# 57878