REPORT OF SURVEY

for

Mr. and Mrs. W. F. Swick
1305 N. 8th Street
Avondale, Arizona

of

the West 231 feet of the Parcel of Land described in Book of Deeds 251, Page 559, Maricopa County Records, Arizona.

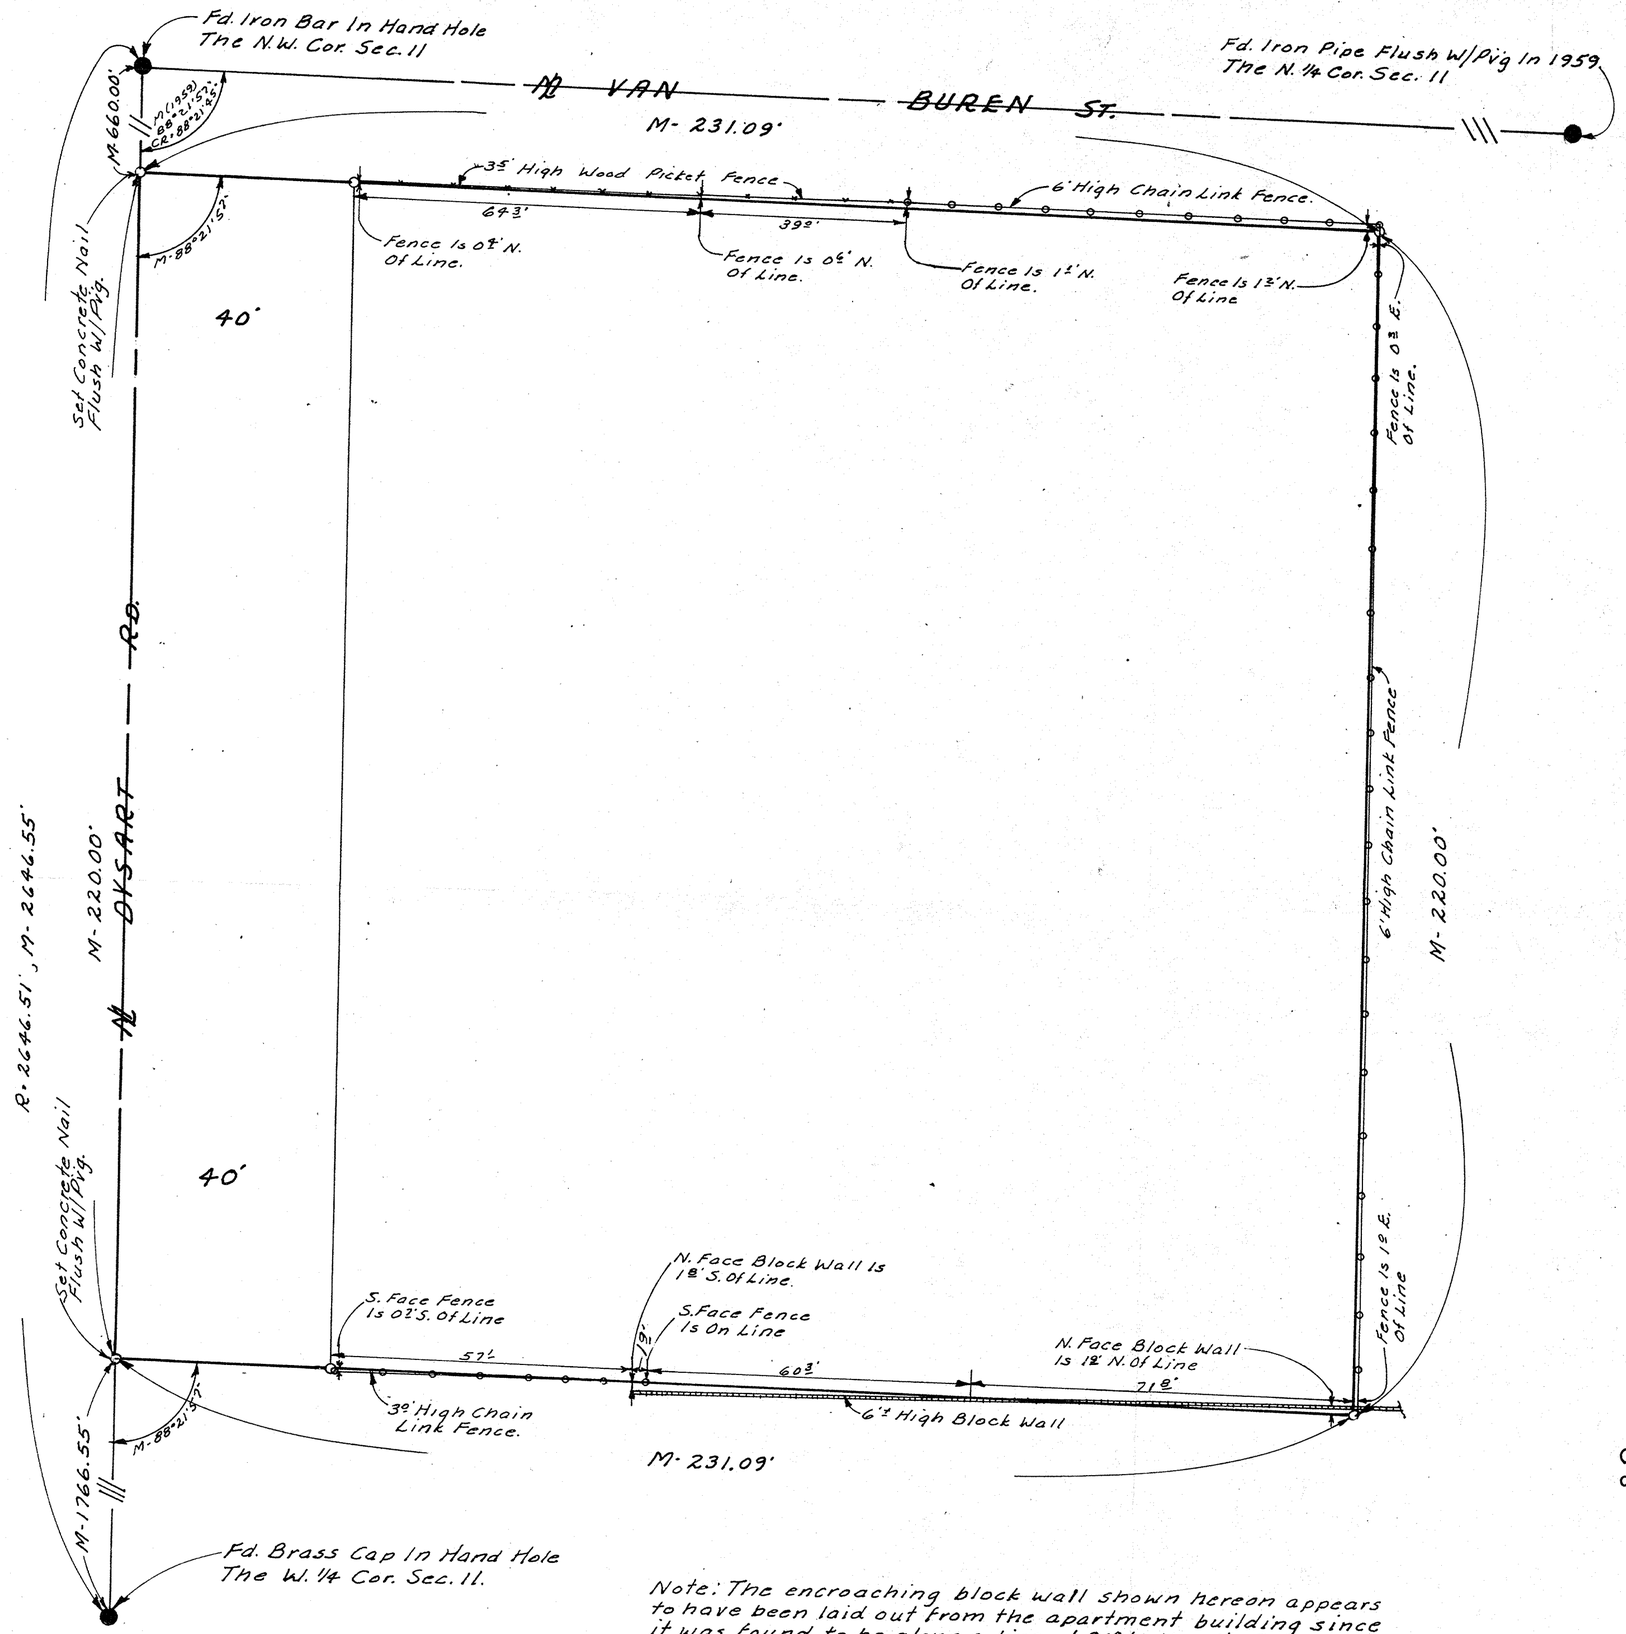

Note: The encroaching block wall shown hereon appears to have been laid out from the apartment building since it was found to be along a line at 90° to the ½ Dysart Rd. and my "as-built" drawing No. L-59-128, Dated June, 1959 for S.H.&W. Building Enterprises shows the building (now called Hideaway Apts.) on the adjoining property to the south was laid out squared to the ½ Dysart Rd.

N

Scale: 1" = 20'

LEGEND

- ● = Monument Found
- ● = Iron Pipe or Iron Bar Found
- ○ = 1/2" I.D. Iron Pipe Tagged L.S. 1681 Set This Survey
- R = Data From Maricopa County Records
- CR = Calculated From R
- M = Measured in Field
- CM = Calculated From M
- ×-×-×-× = Wire or Wood Fence
- -o-o-o- = Chain Link Fence
- ═══ = Block or Stone Wall

CERTIFICATION: This will certify that the survey shown hereon was done under my supervision during the month of Jan. 1975

Eugene V. Skelley

EUGENE V. SKELLEY 1/27/75

ARIZONA SURVEYING SERVICE

2802 W. Solano Dr., N., Phoenix, Arizona
Drawing No. L-75-1821 Phone 242-0539

DIN # 58487-1