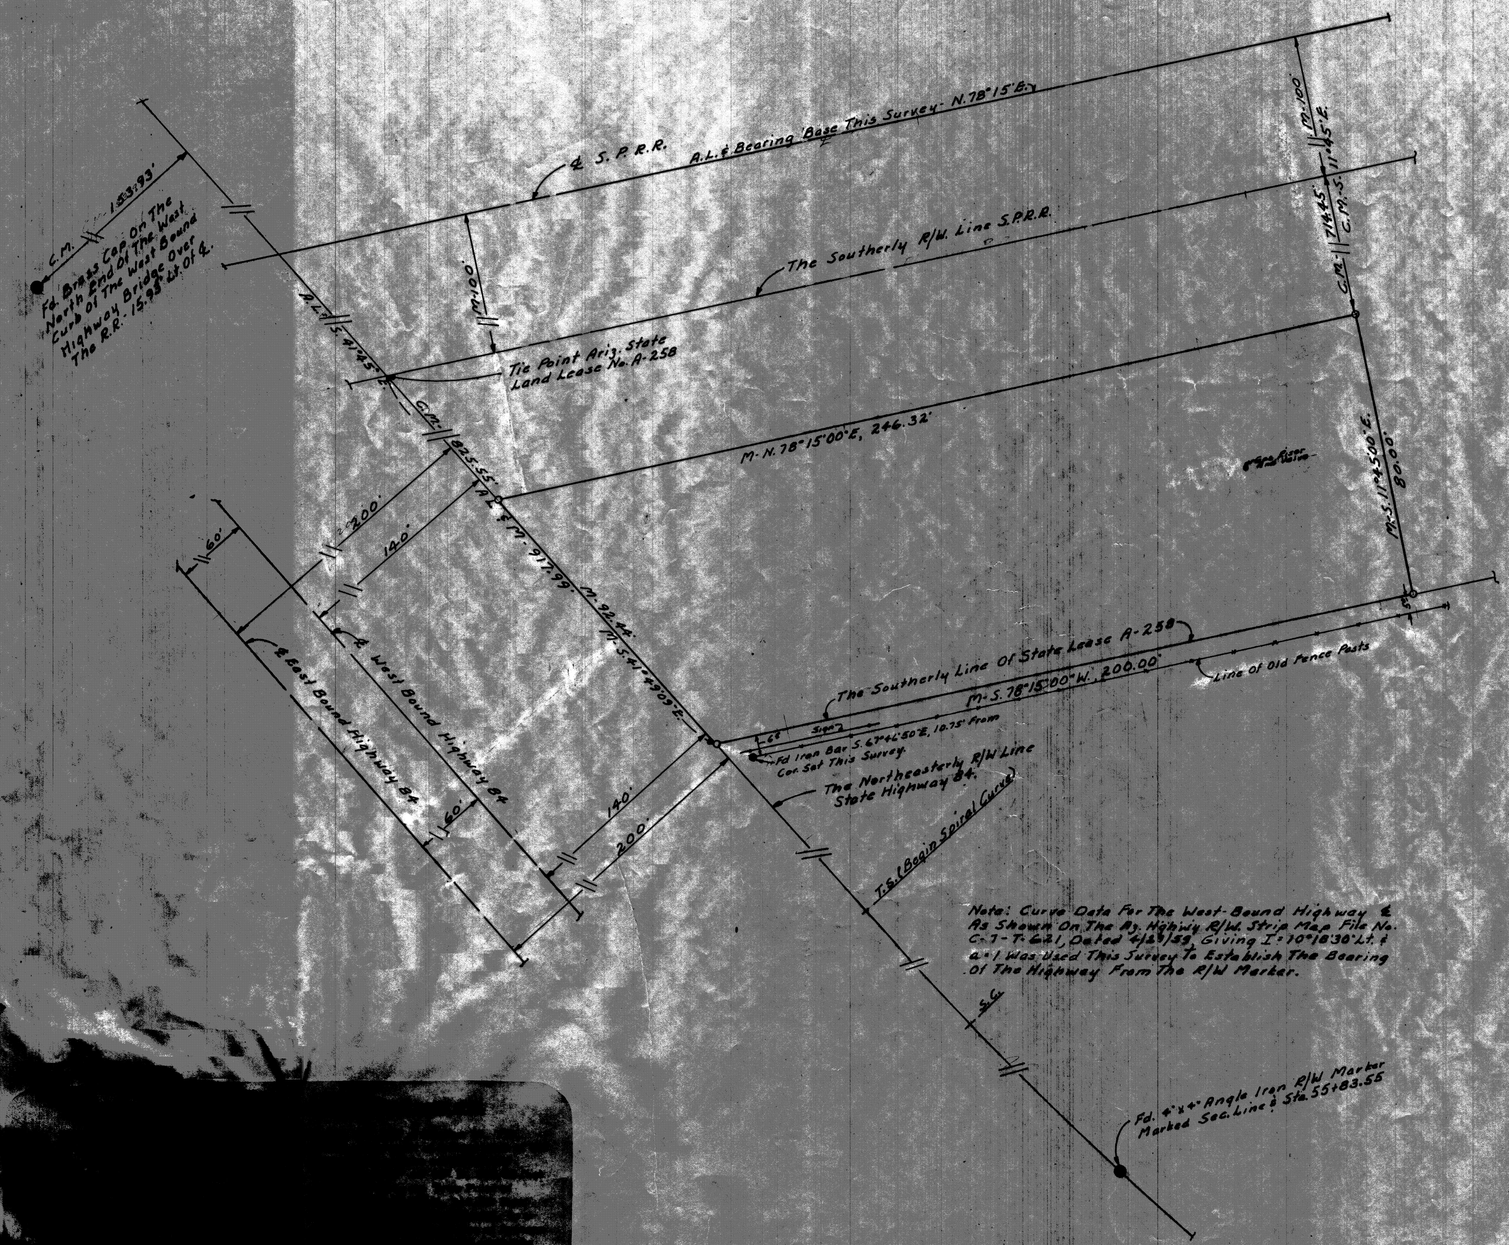

REPORT OF SURVEY

OF

The Portion Of Sec. 32, T.5S., R.4W., G.&S.R.B.&M., Maricopa Co., Ar. Shown Hereon.

FOR

THE TOWN OF GILA BEND

GILA BEND, ARIZ.

N

Scale: 1" = 20'

LEGEND

- ● = Monument Found
- ● = Iron Pipe or Iron Bar Found
- ○ = 1/2" I.D. Iron Pipe Tagged L.S. 1681 Set This Survey
- R = Data From Maricopa County Records
- CR = Calculated From R
- M = Measured In Field
- CM = Calculated From M
- = Wire or Wood Fence
- = Chain Link Fence
- A.L. = Data From State Of Ariz. Lease No. A-258

Arizona State Hghwy Dept. References:

1- R/W Map File No. C-7-T-621 Dated 4/28/59
2- As-Built Plans F-FG-102-2(2), Sheets 2 Thru 5
3- Tabulated Spiral Tables
4- Overpass Bridge Sheet F-FG-102-2(2), Sheet 18

DIN-59196

CERTIFICATION: This will certify that the survey shown hereon was done under my supervision during the months of July & August, 1974.

REFERENCES

NO.	DATE	REVISIONS	BY	CHK.	NO.	DATE	REVISIONS	BY	CHK.
4					3				
3					2				
2					1				
1									

DESIGNED
DRAWN
CHECKED
APPROVED

HASTAIN & DEATHERAGE
CONSULTING ENGINEERS
PHOENIX, ARIZONA

CLIENT
TOWN OF GILA BEND, ARIZONA

SURVEY OF WATER TANK SITE
GILA BEND ARIZONA

COMMISSION NO. 1616
SHEET NO. 1 of 1
DATE AUG., 1974

HALE BLUEPRINT CO.

L-74-981