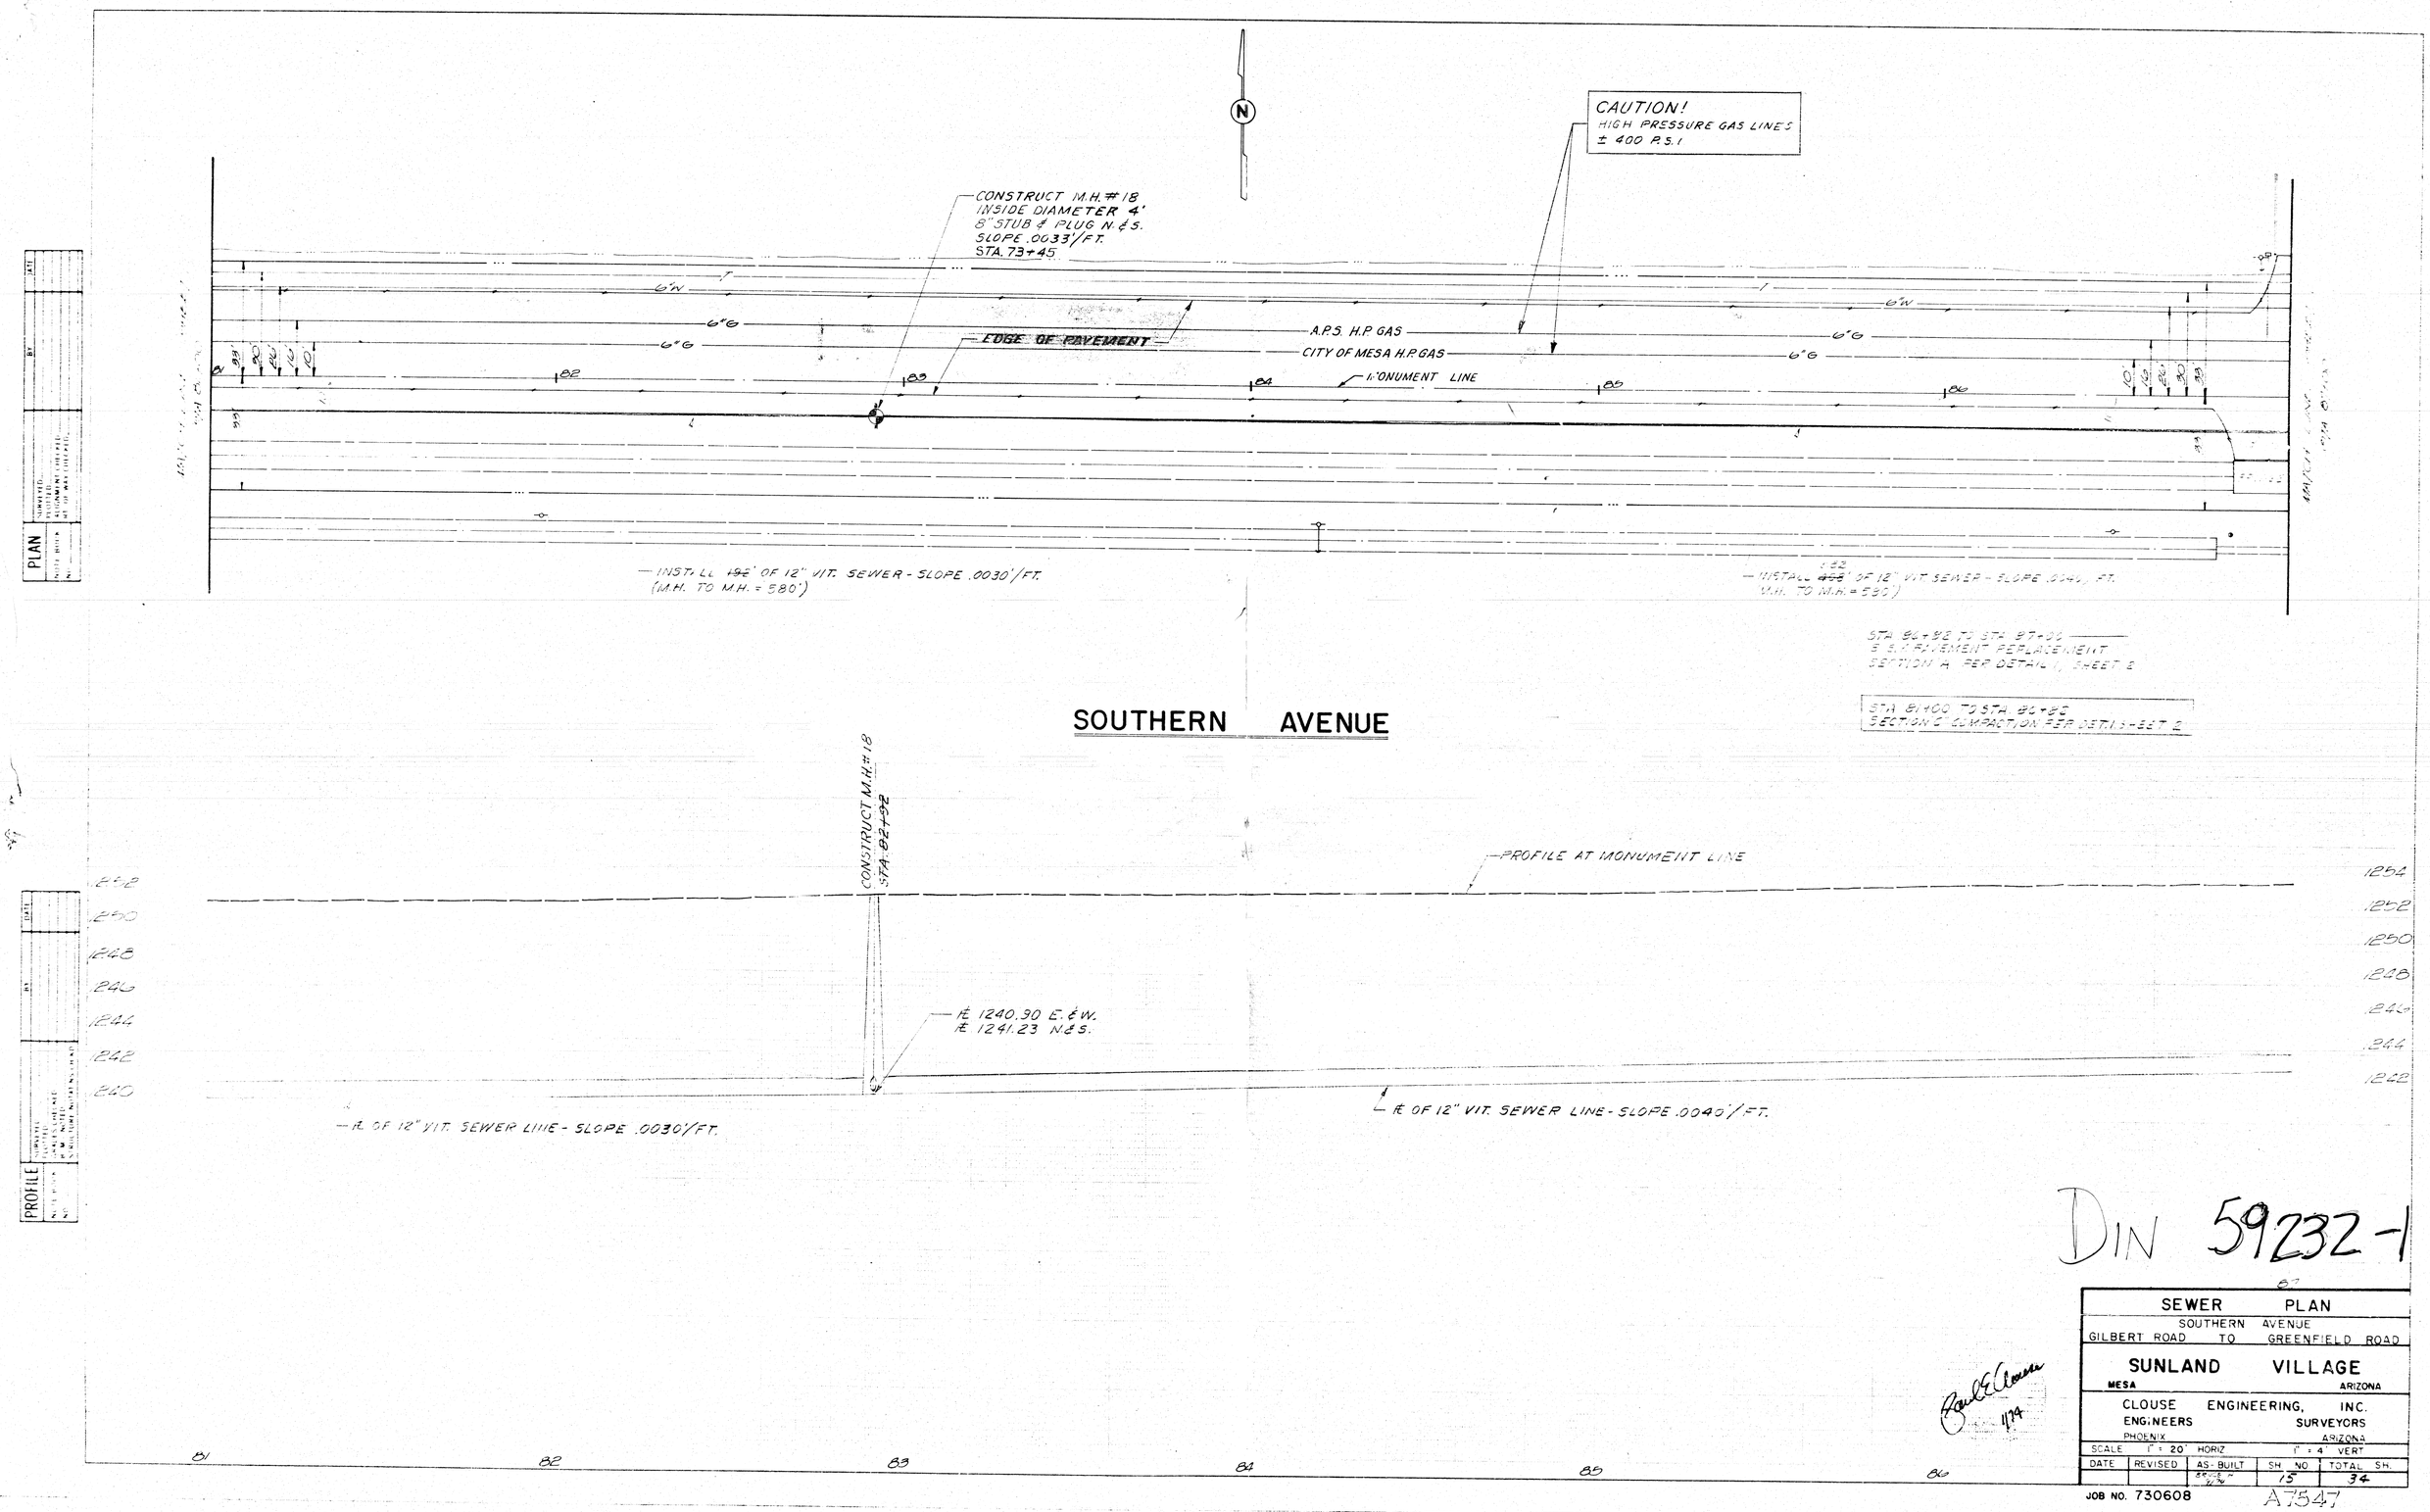

DIN 59232-1

SEWER PLAN			
SOUTHERN AVENUE			
GILBERT ROAD TO GREENFIELD ROAD			
SUNLAND VILLAGE			
MESA			ARIZONA
CLOUSE ENGINEERING, INC.			
ENGINEERS		SURVEYORS	
PHOENIX			ARIZONA
SCALE 1" = 20' HORIZ		1" = 4' VERT	
DATE	REVISED	AS-BUILT	SH. NO. 15 / TOTAL SH. 34

JOB NO. 730608

A7547