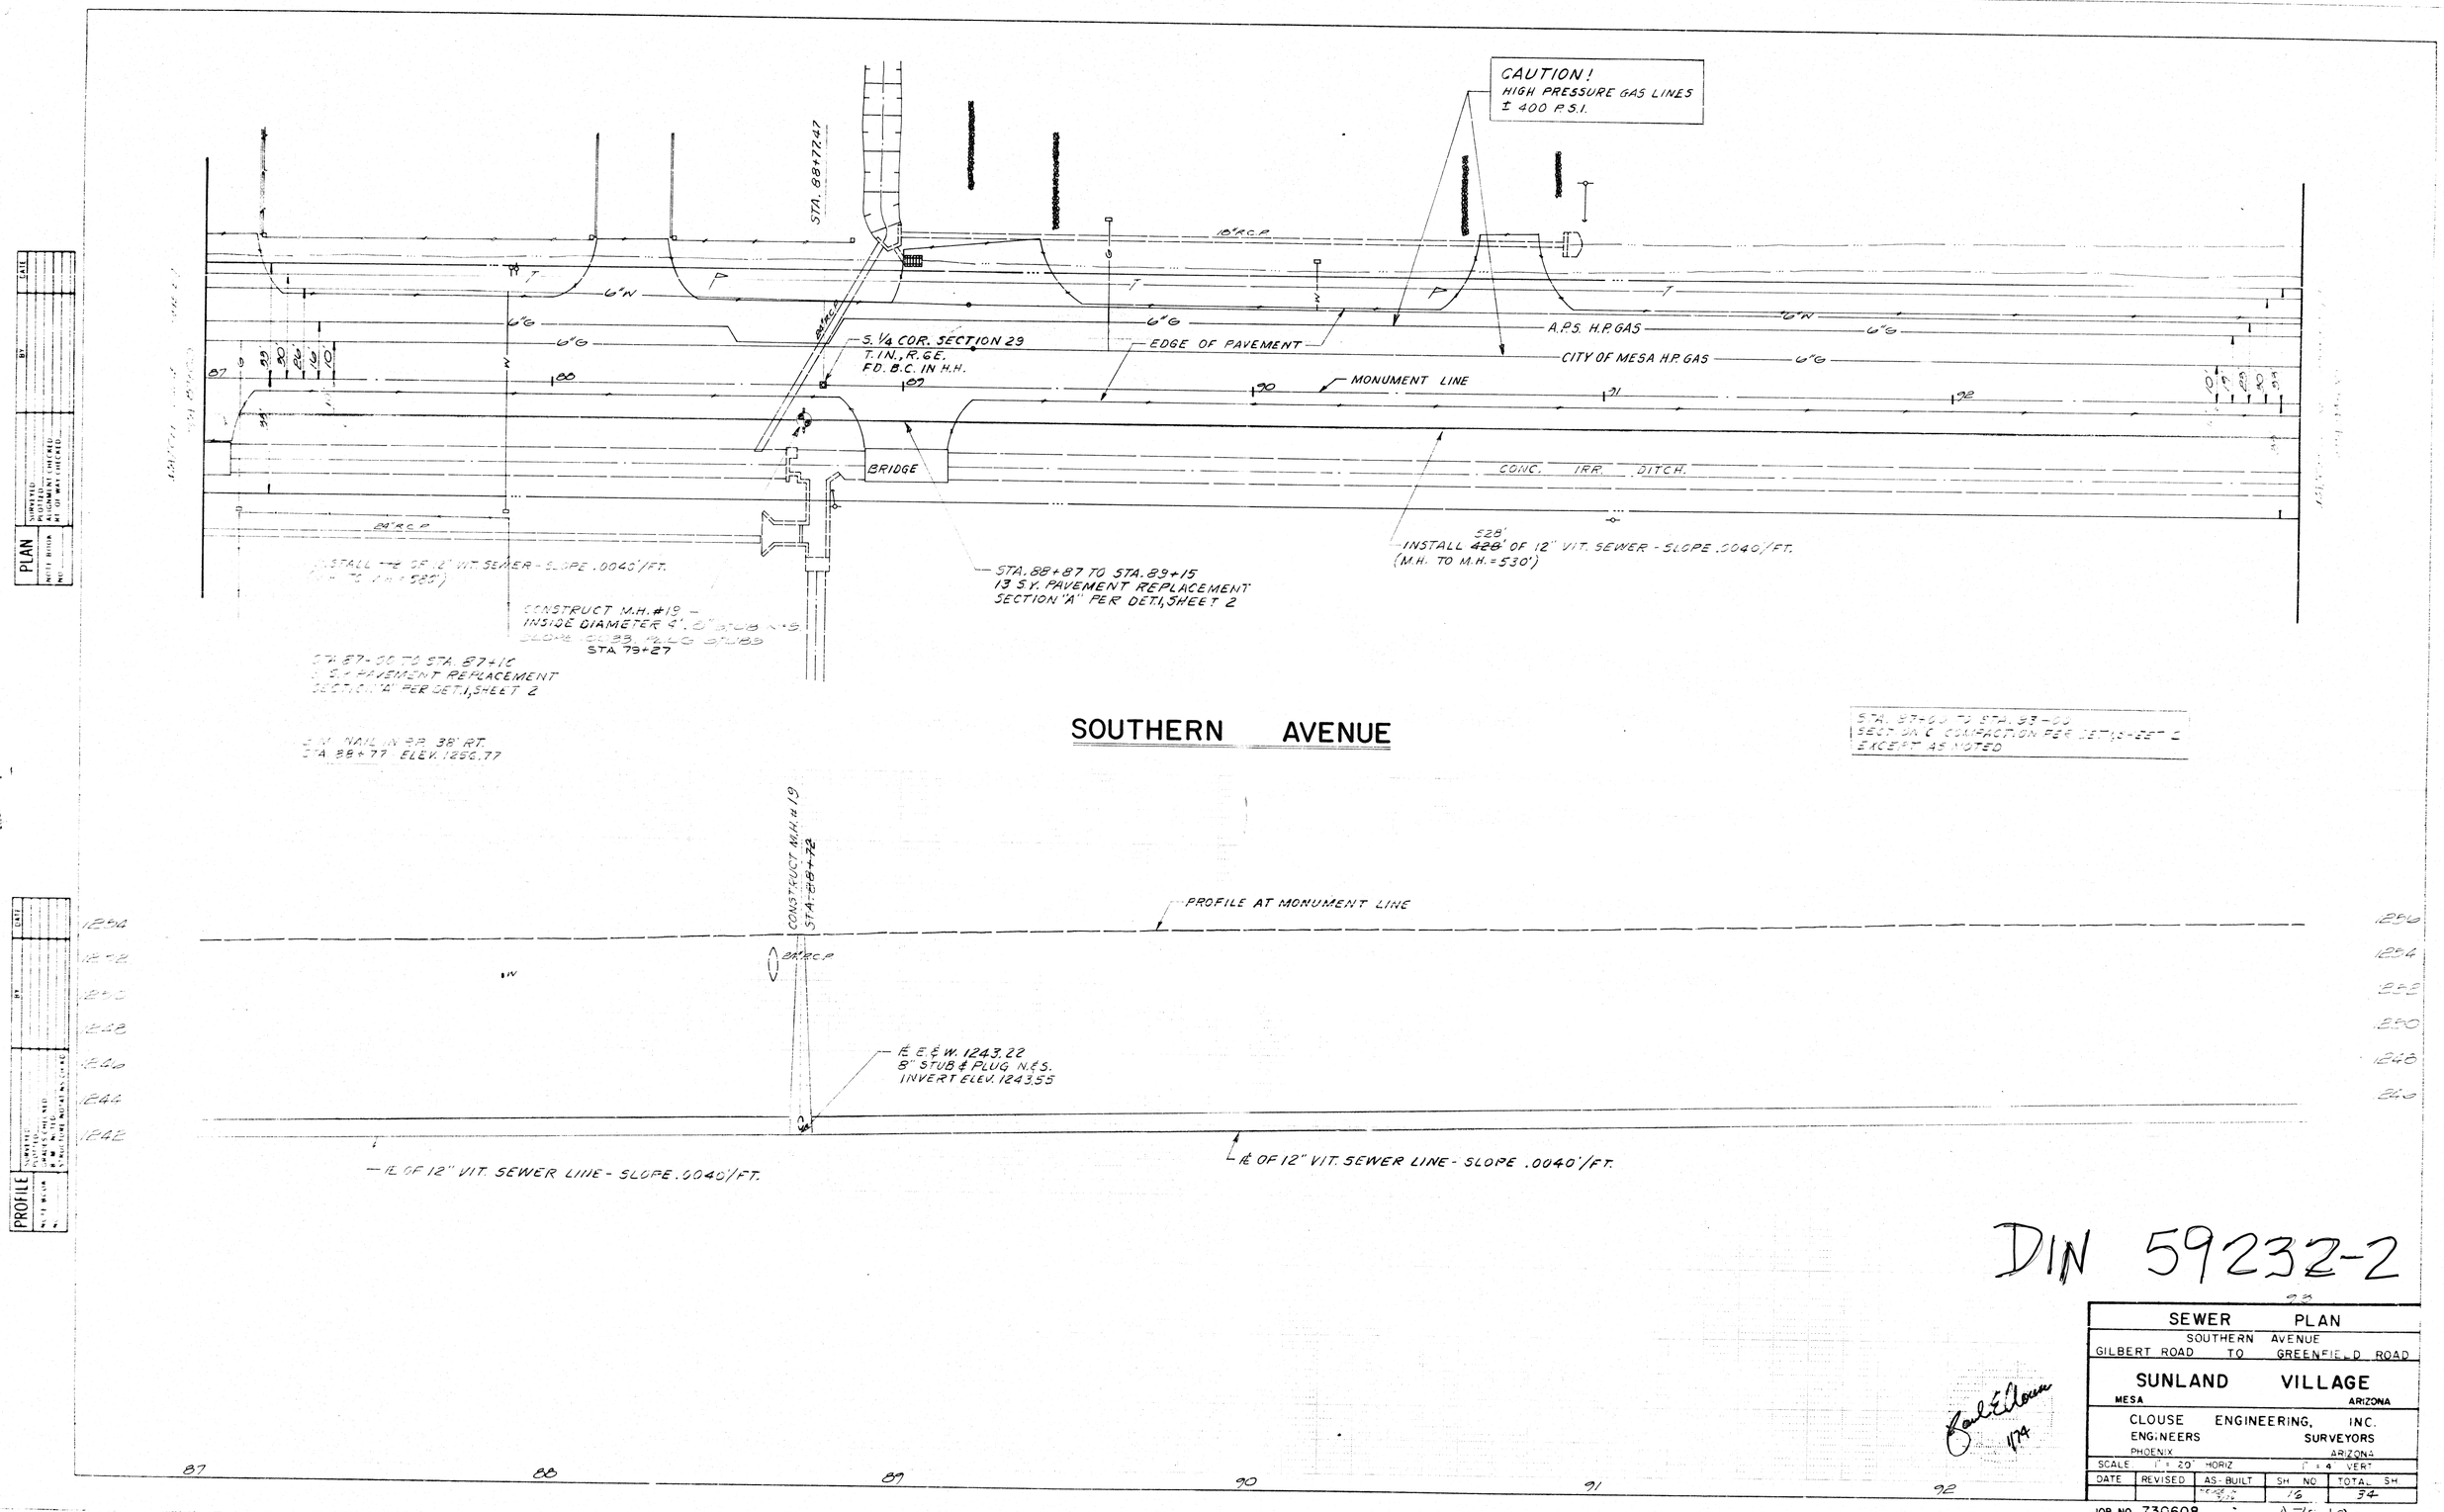

DIN 59232-2

SEWER PLAN			
SOUTHERN AVENUE			
GILBERT ROAD TO GREENFIELD ROAD			
SUNLAND VILLAGE			
MESA ARIZONA			
CLOUSE ENGINEERING, INC.			
ENGINEERS SURVEYORS			
PHOENIX ARIZONA			
SCALE 1" = 20' HORIZ		1" = 4 VERT	
DATE	REVISED	AS-BUILT	SH NO 16 / TOTAL SH 34

JOB NO. 73C608

A7548