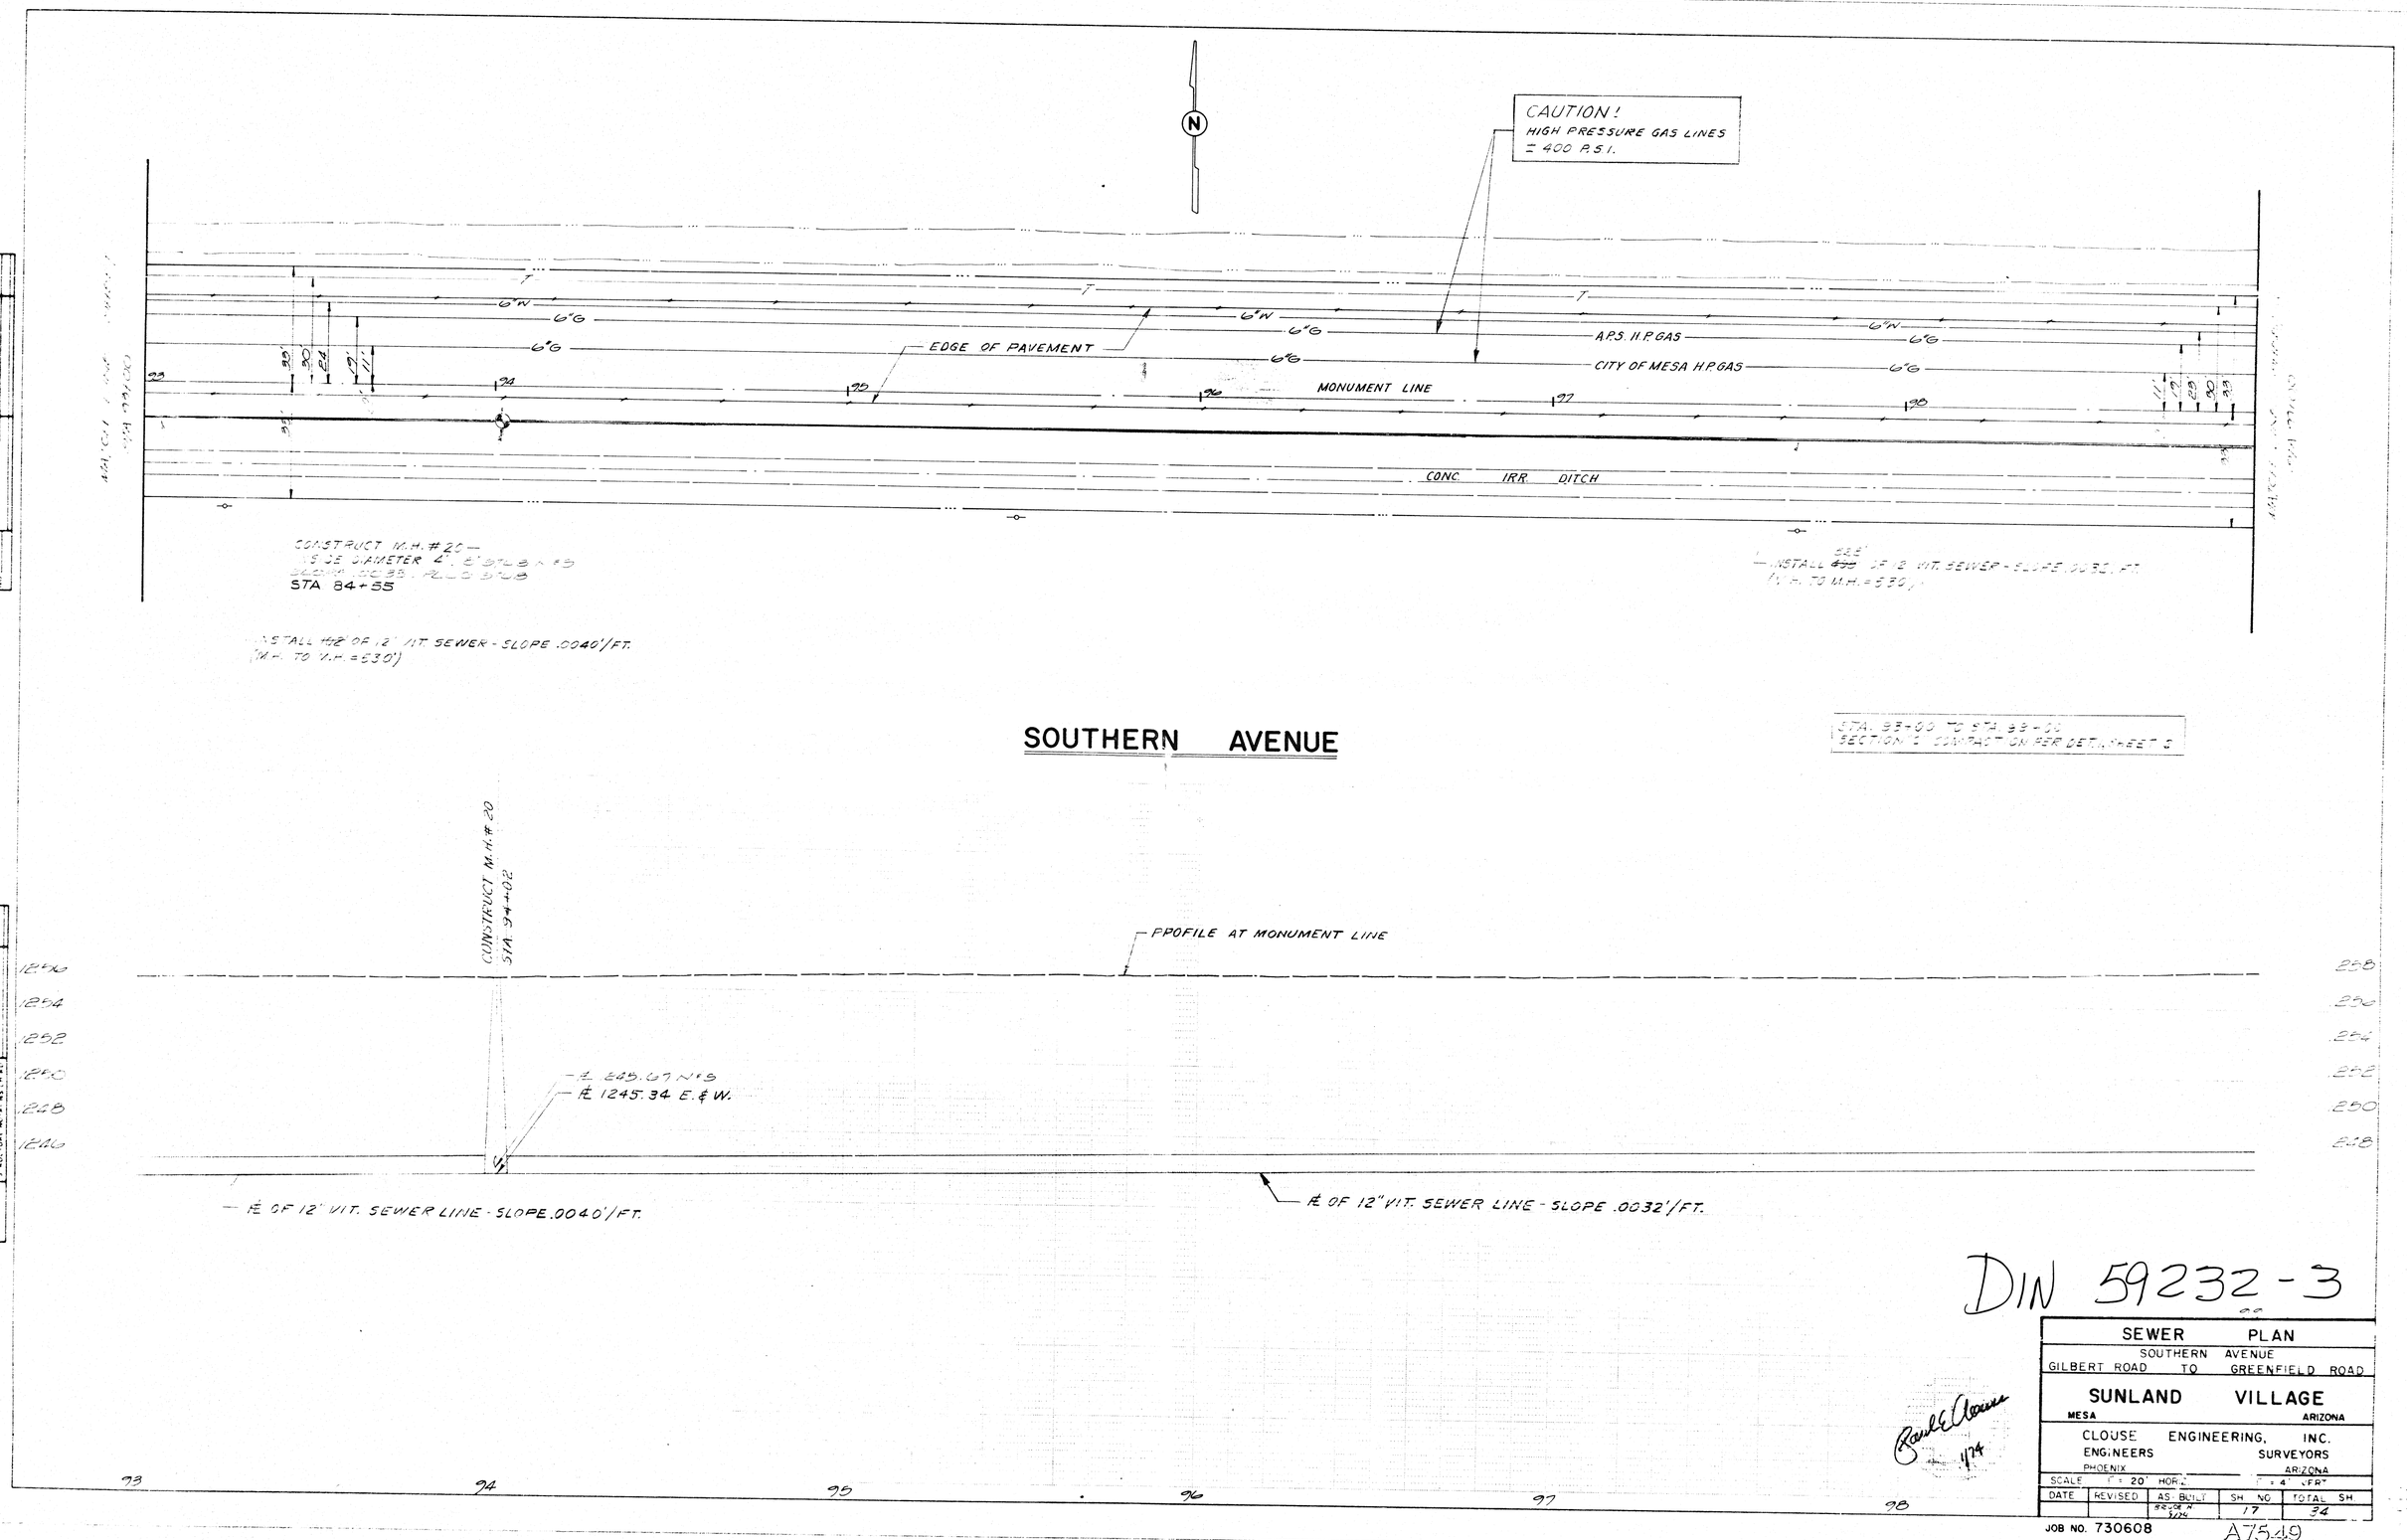

PLAN

PROFILE

DIN 59232-3

SEWER PLAN				
SOUTHERN AVENUE				
GILBERT ROAD TO GREENFIELD ROAD				
SUNLAND VILLAGE				
MESA ARIZONA				
CLOUSE ENGINEERING, INC.				
ENGINEERS SURVEYORS				
PHOENIX ARIZONA				
SCALE 1" = 20' HORIZ. 1" = 4' VERT.				
DATE	REVISED	AS BUILT	SH. NO.	TOTAL SH.
		BRUCE H. 5/74	17	34

JOB NO. 730608

A7549