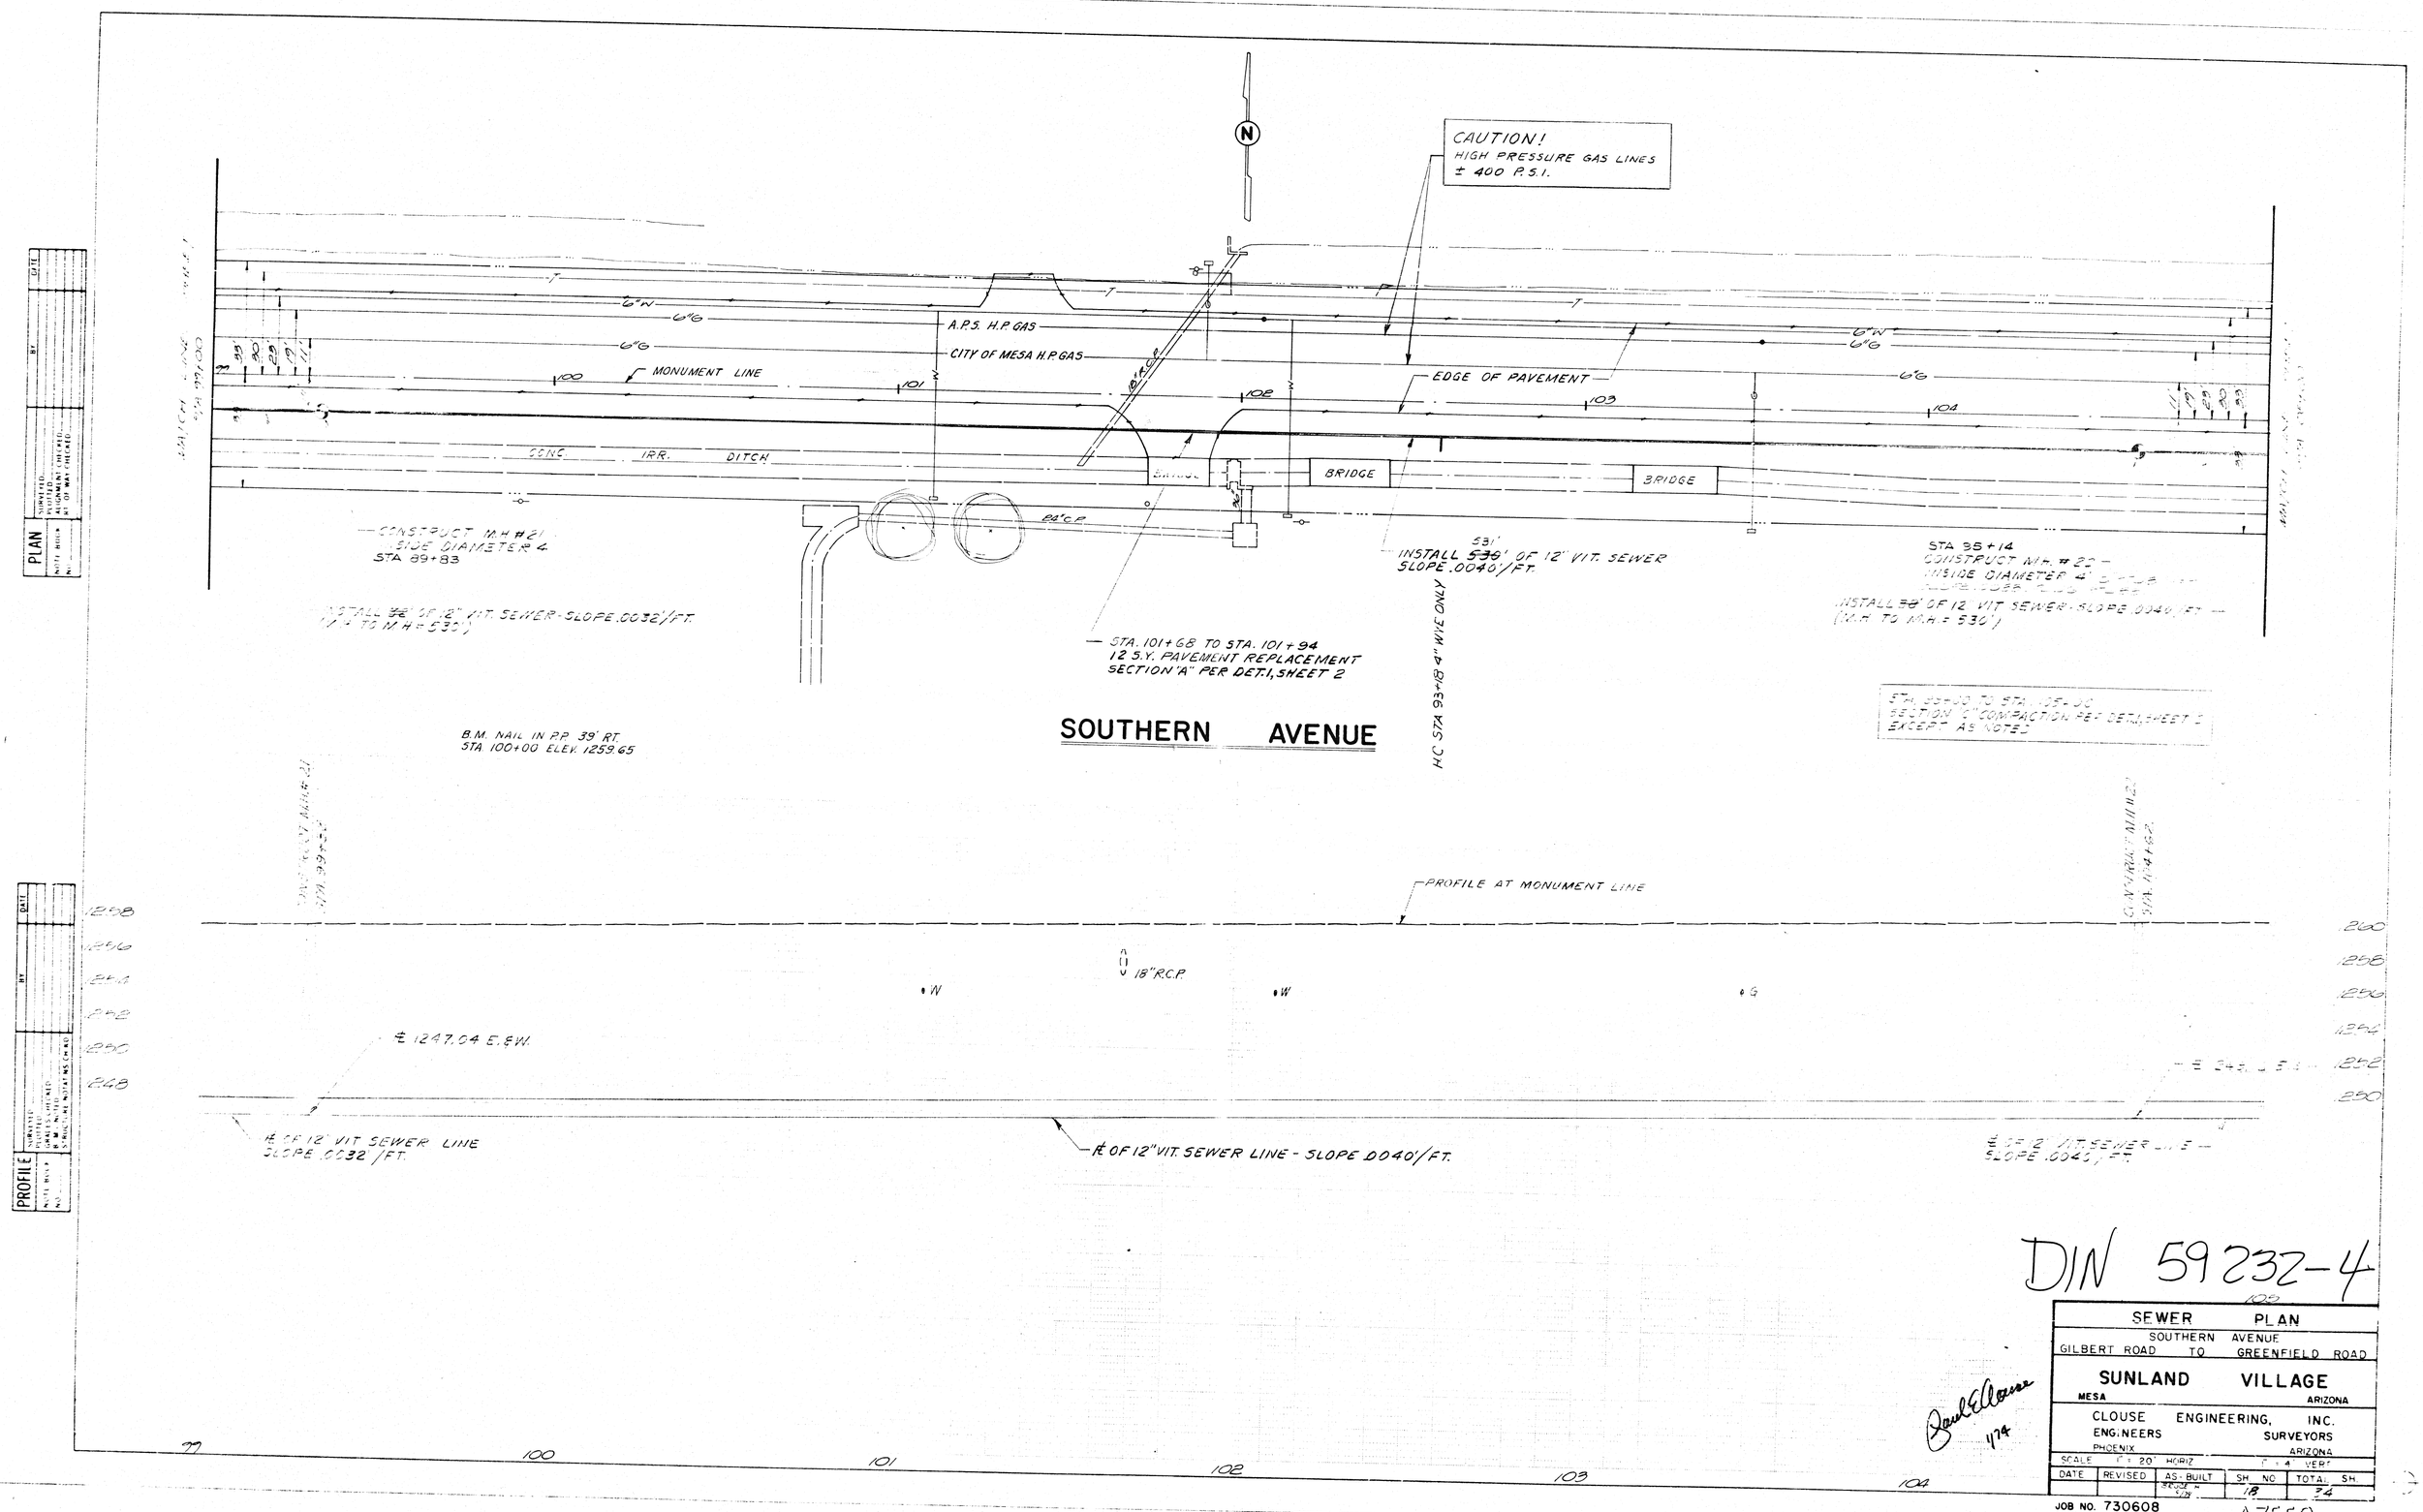

DIN 59232-4

SEWER PLAN				
SOUTHERN AVENUE				
GILBERT ROAD TO GREENFIELD ROAD				
SUNLAND VILLAGE				
MESA ARIZONA				
CLOUSE ENGINEERING, INC.				
ENGINEERS SURVEYORS				
PHOENIX ARIZONA				
SCALE 1" = 20' HORIZ 1" = 4' VERT				
DATE	REVISED	AS-BUILT	SH. NO.	TOTAL SH.
			18	34

JOB NO. 730608

A7550