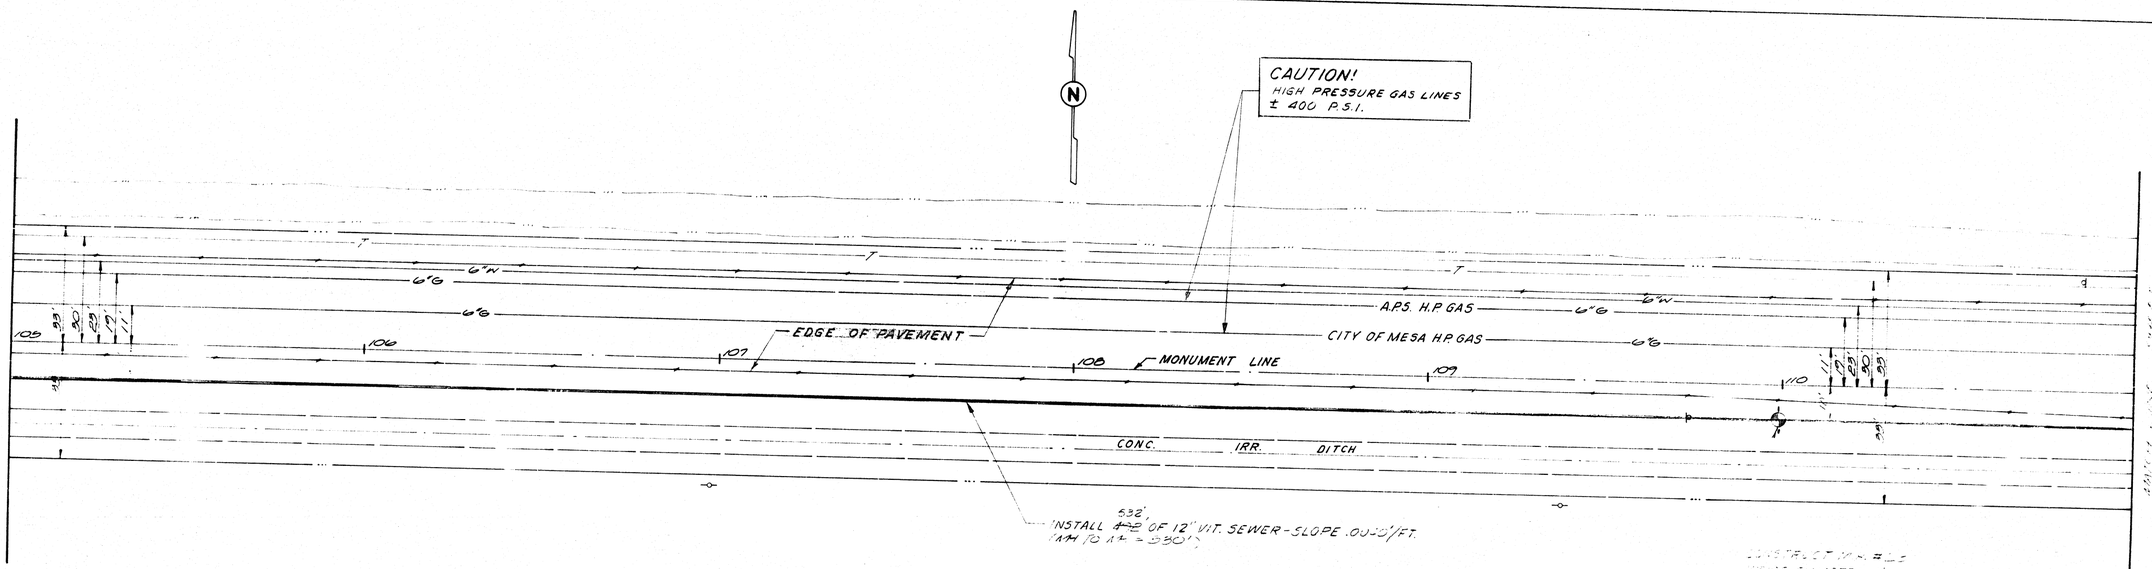

SOUTHERN AVENUE

B.M. NAIL IN P.P. 39' RT
STA. 109+38 ELEV. 1263.75

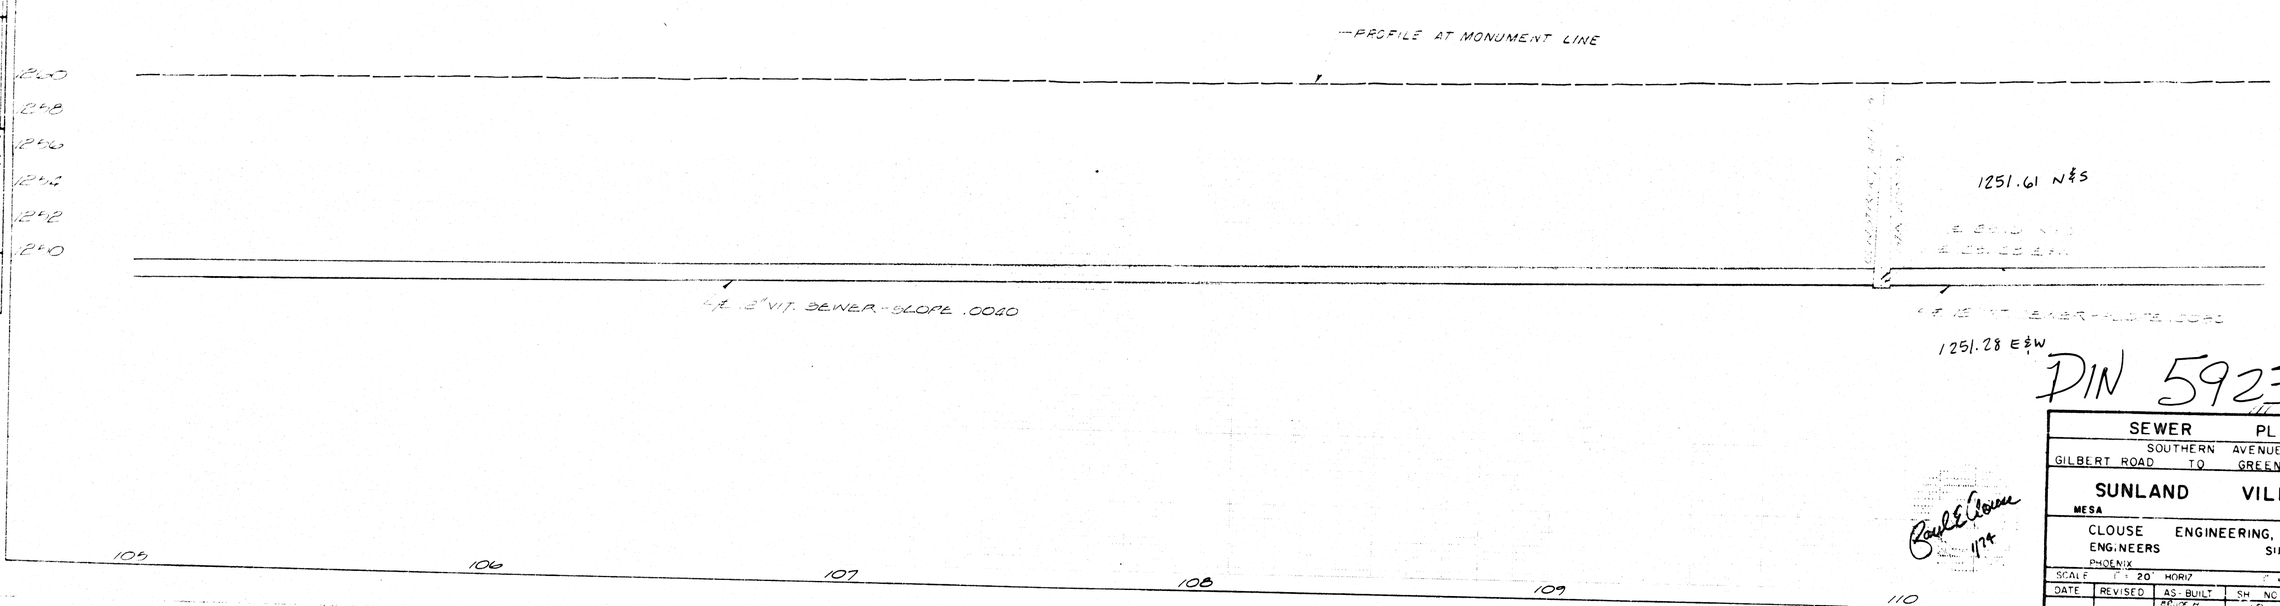

DIN 59232-5

SEWER PLAN			
SOUTHERN AVENUE GILBERT ROAD TO GREENFIELD ROAD			
SUNLAND VILLAGE MESA ARIZONA			
CLOUSE ENGINEERING, INC. ENGINEERS SURVEYORS PHOENIX ARIZONA			
SCALE 1" = 20' HORIZ 1" = 4' VERT			
DATE	REVISED	AS-BUILT	SH NO / TOTAL SH
			19 / 34

JOB NO. 730608

A7551