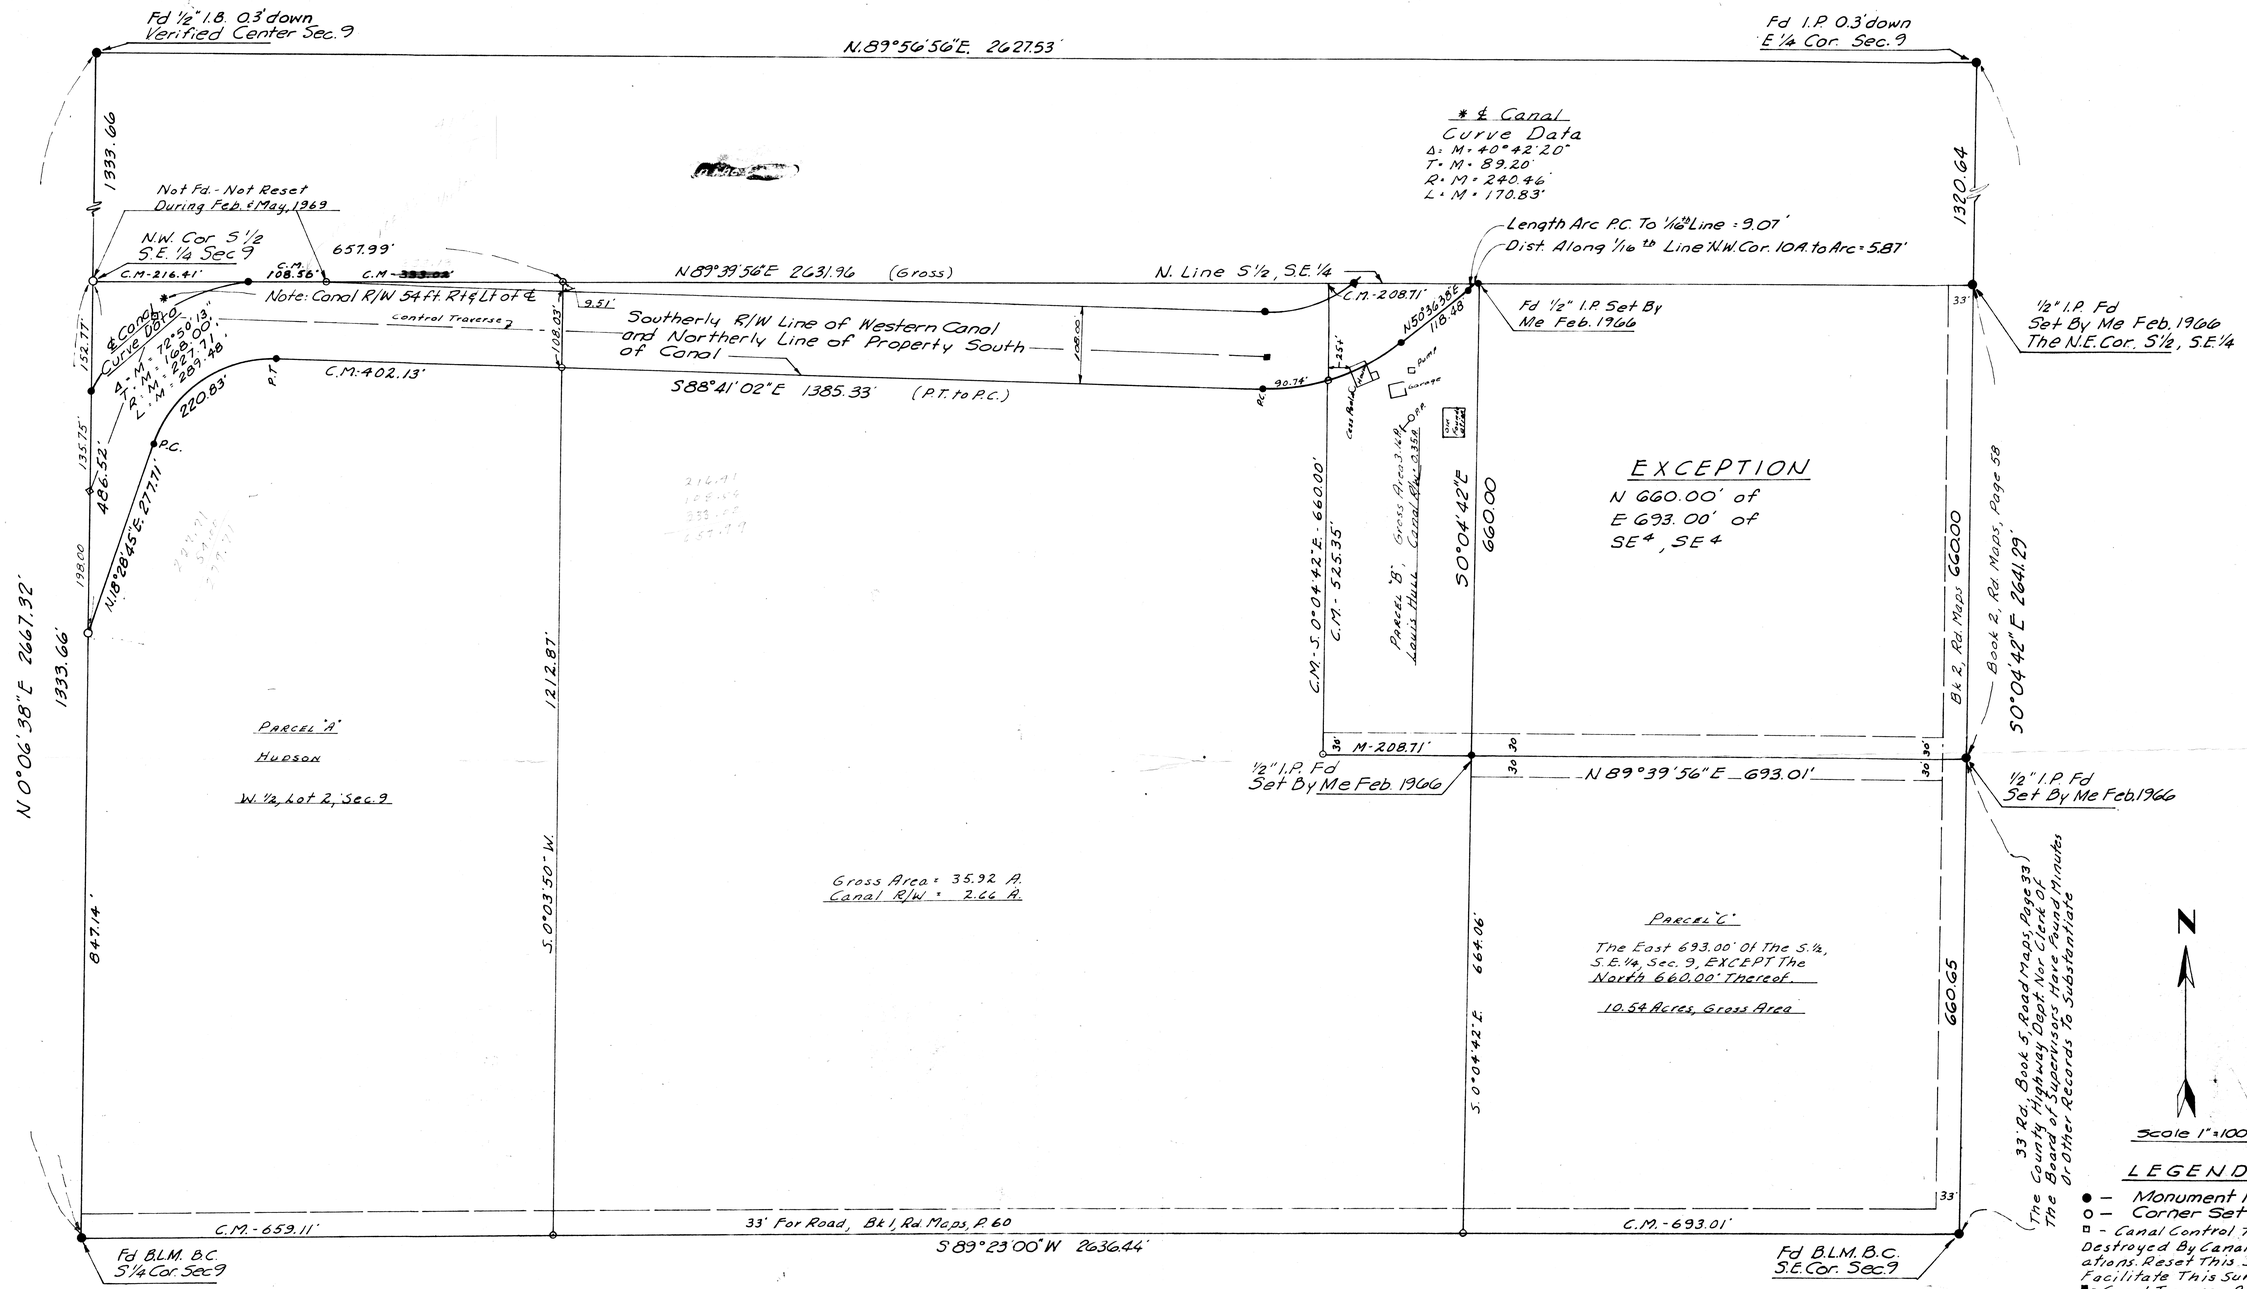

LEGEND

- ● – Monument Found
- ○ – Corner Set This Survey
- □ – Canal Control Traverse Pt's Destroyed By Canal Lining Operations. Reset This Survey To Facilitate This Survey
- ■ – Canal Traverse P.I. Found

M = Measured In Field, C.M. = Calc. From M.

Note:

1- This Drawing amends Drawing L-66-446

2- For Portions Lying North of Canal See Drawing L-66-446-A

REPORT OF SURVEY

OF

That Portion of the S½, S.E.¼, Sec. 9, T.1.S., R.2.E., G. & S.R.B. & M., Mar. Co. Arizona Lying South of the Southerly Right-of-Way Line of the Western Canal, EXCEPT the N. 660.00 feet of the East 693.00 feet thereof. Containing 63.85 A.

For

Mrs. Lulo S. Hull

Laveen, Arizona

This will certify that the survey of Parcels A, B, & C. Shown hereon was done by me in Feb. & May 1969. Also certain additional information has been added pertaining to the entire S½, S.E.¼, Sec. 9.

Eugene Shelby 7/23/69

DIN 59783

This will certify that the survey shown hereon was made by me during Oct.-Nov. 1966 and Jan. 1967.

Eugene Shelby 1-25-67

Revised To Make Distance From ℄ Canal To The S.¼ Cor. Sec. 9 Conform To M.C.R.

Eugene Shelby 7/23/69

ARIZONA SURVEYING SERVICE

~~114 N 7th St~~ PHOENIX, ARIZONA

Drawing No. ~~L-66-446-B~~ L-69-1546-B

2802 W. Solano Dr., North