This record of Survey is filed to amend, correct and supercede that record of Survey as recorded in Book 246 at page 33.

STATE OF ARIZONA } ss
County of Maricopa }

I hereby certify that the within instrument was filed and recorded at request of

in Book 258
on page 32

Witness my hand and official seal the day and year aforesaid.

Bill Henry
County Recorder
By
Deputy Recorder

NOV 4 - 83 -2 30

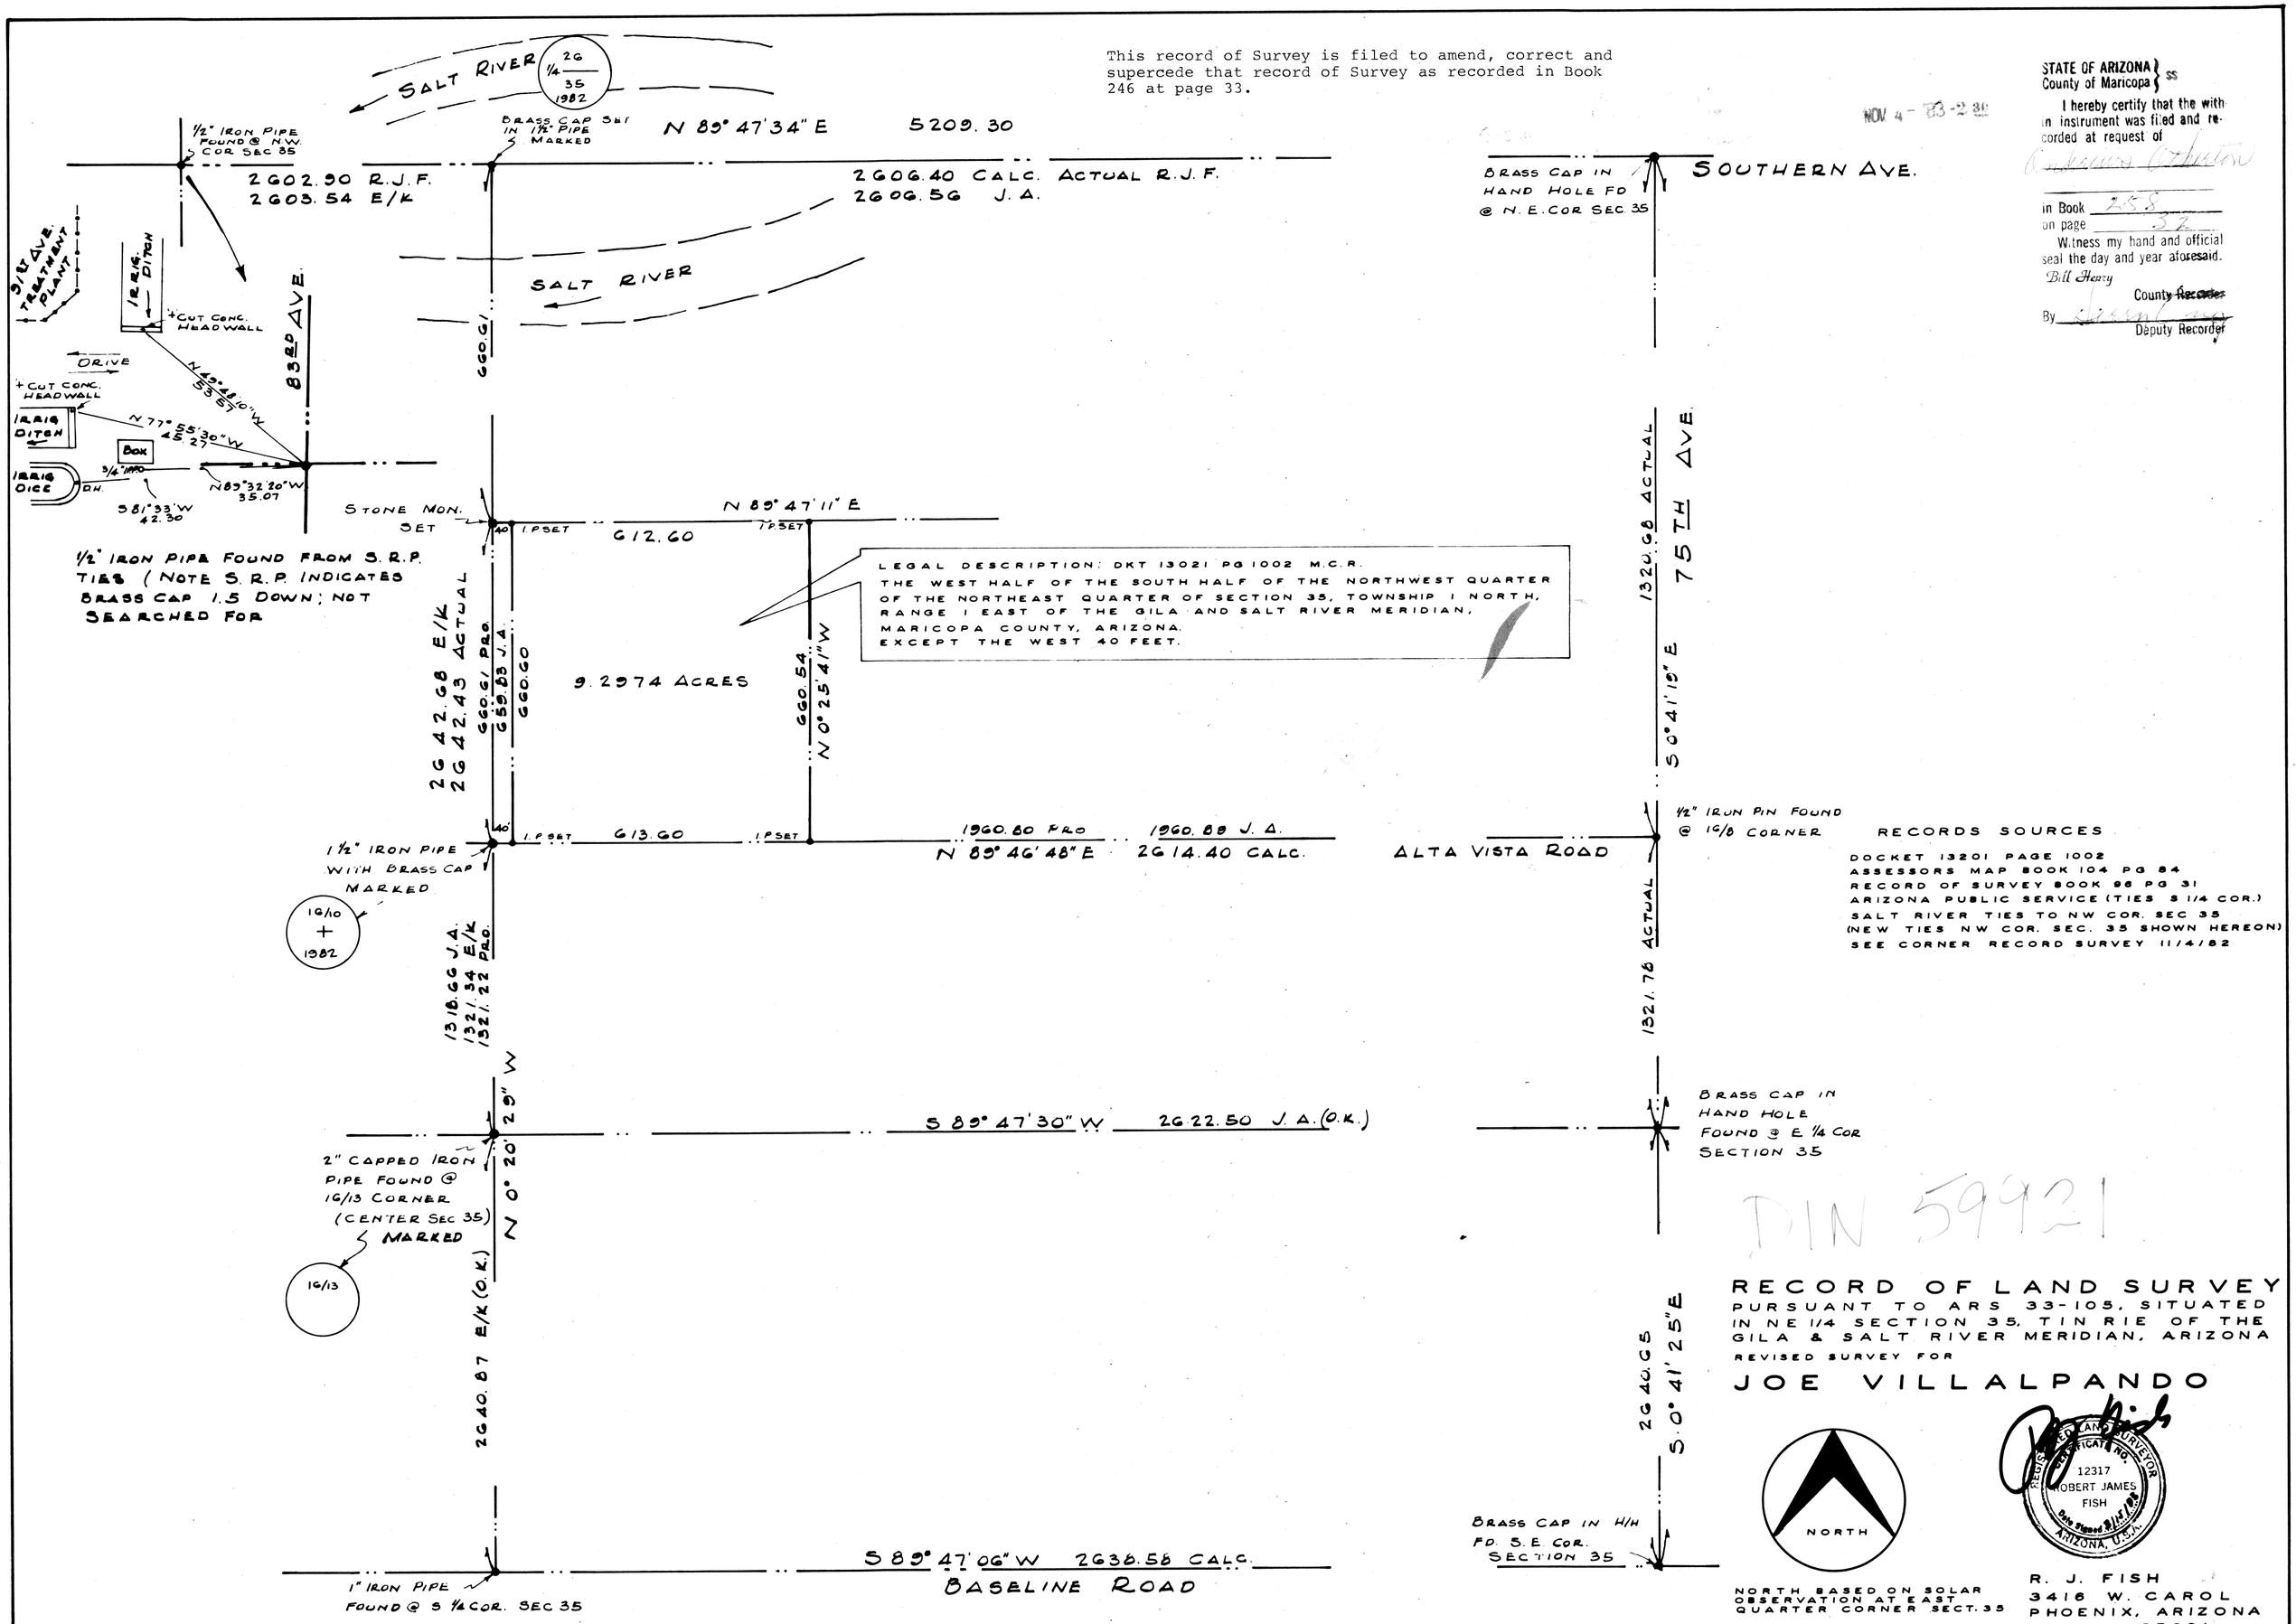

RECORDS SOURCES

DOCKET 13201 PAGE 1002
ASSESSORS MAP BOOK 104 PG 84
RECORD OF SURVEY BOOK 96 PG 31
ARIZONA PUBLIC SERVICE (TIES S 1/4 COR.)
SALT RIVER TIES TO NW COR. SEC 35
(NEW TIES NW COR. SEC. 35 SHOWN HEREON)
SEE CORNER RECORD SURVEY 11/4/82

DIN 59921

RECORD OF LAND SURVEY

PURSUANT TO ARS 33-105, SITUATED IN NE 1/4 SECTION 35, T1N R1E OF THE GILA & SALT RIVER MERIDIAN, ARIZONA

REVISED SURVEY FOR

JOE VILLALPANDO

REGISTERED LAND SURVEYOR
CERTIFICATE NO.
12317
ROBERT JAMES FISH
Date Signed 8/17/83
ARIZONA, U.S.A.

NORTH BASED ON SOLAR OBSERVATION AT EAST QUARTER CORNER SECT. 35

THIS MAP NOT DRAWN TO SCALE

R. J. FISH
3416 W. CAROL
PHOENIX, ARIZONA
85021
866 2126

VILLALPANDO 282 3007 FISH

A2-001