Sheet 1 of 2

LEGEND:
- ● Corners found
- o Corners Set
- R. Record dist.
- M. Measured in field.

Scale 1" = 40'

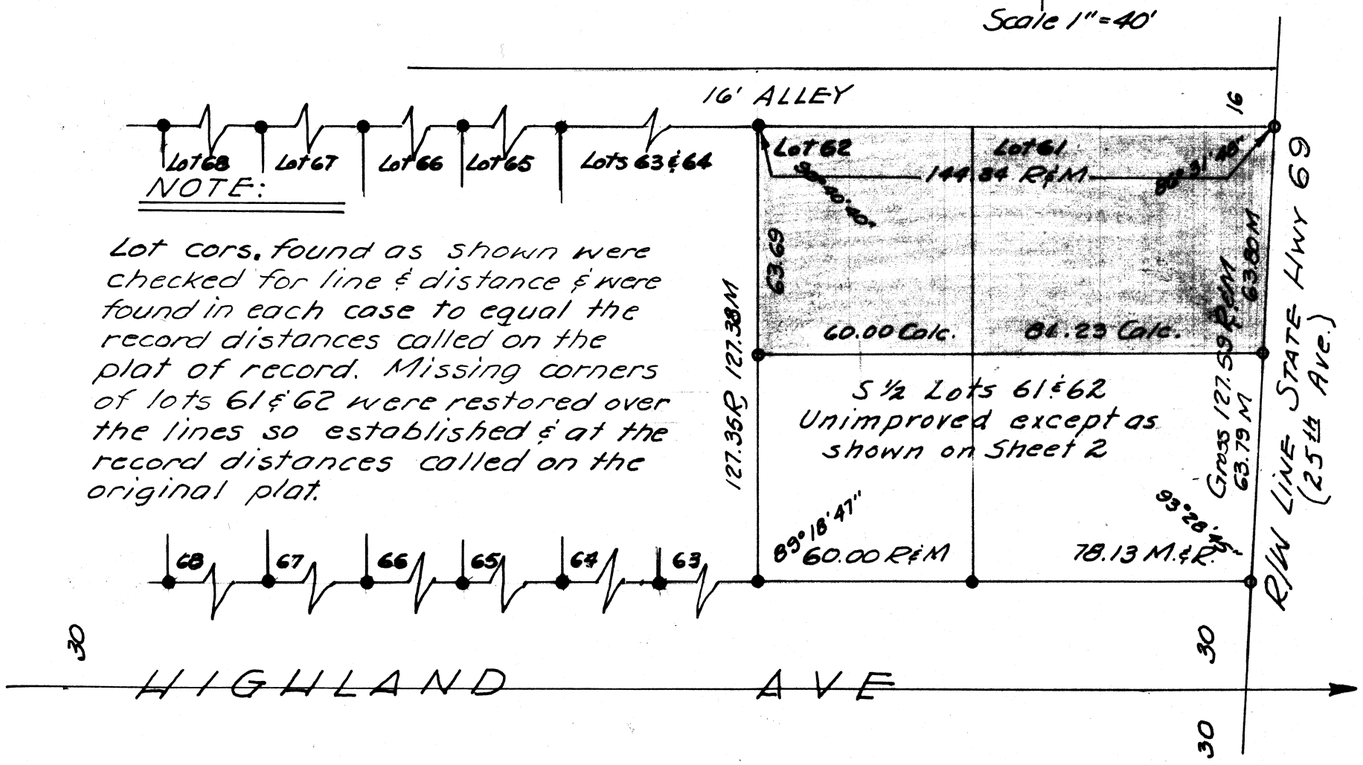

NOTE:

Lot cors. found as shown were checked for line & distance & were found in each case to equal the record distances called on the plat of record. Missing corners of lots 61 & 62 were restored over the lines so established & at the record distances called on the original plat.

NOTE: Monumentation lying in R/W Hwy. 69 destroyed by const. Not Replaced by Ariz. State Hwy Dept.

This is to certify that the survey of the premises hereon platted was made by H.L. Meredith under my supervision in Sept. 1962.

Eugene V Skelly

AMENDMENT:

An easement over the easterly four feet of Lot 61, measured at right angles from the lot line for storm drainage recorded in Dkt. 4371, P6. Maricopa Co, Ariz. Records. —— as of 30 November 1962.

Eugene V Skelly

AMENDED
REPORT OF SURVEY
Of the North half of Lots 61 & 62 of Mariposa Homes, a subdivision of part of Sec. 24, T.2N., R.2E. G.& S.R.B.& M. as recorded in Book 38, P.20 of the Maricopa Co., Arizona Records.

Job. L.E. 62-287

ARIZONA SURVEYING SERVICE

DIN 60115-1

Sheet 2 of 2

AS BUILT PLAN
showing location of Bl'dg, Utilities & improvements on the N.½ of Lots 61 & 62 of Mariposa Homes.

Eugene V. Skelly
62

NOTE:

S. face of bl'dg is 4" N. of lot line; S. Face of footing is on line.

SCALE: 1" = 10'

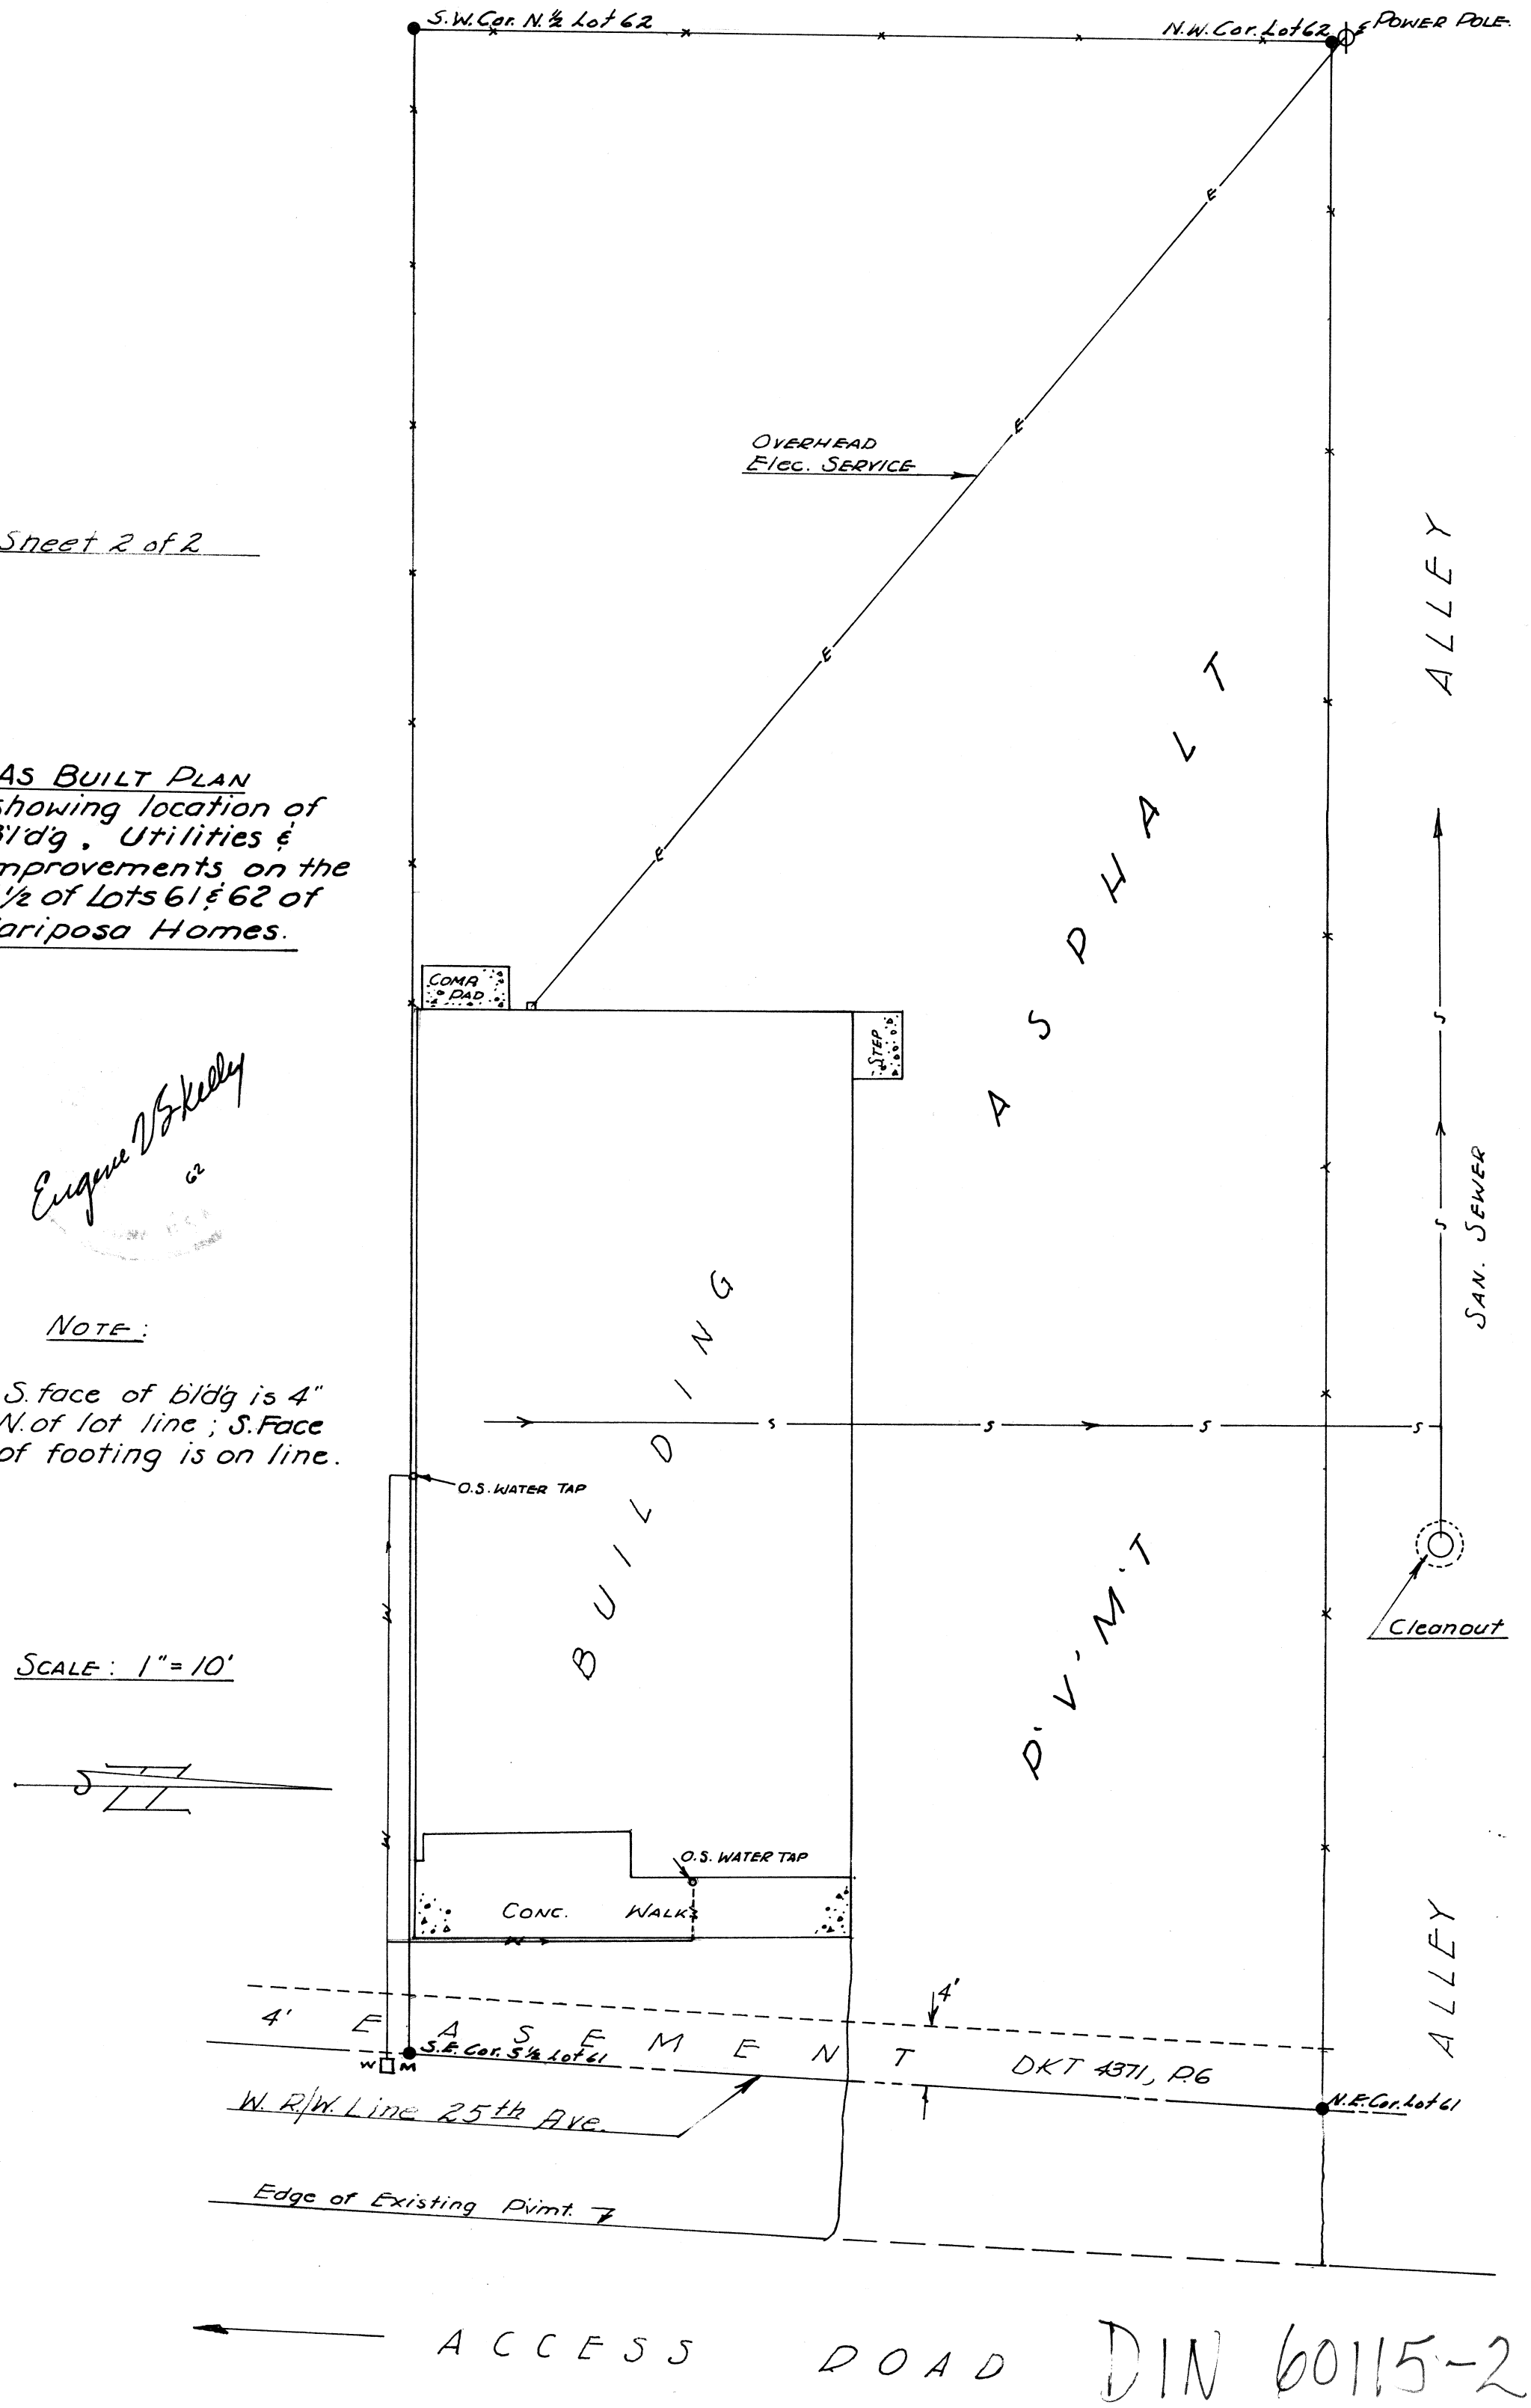

DIN 60115-2

ARIZONA SURVEYING SERVICE
JOB E.62-287