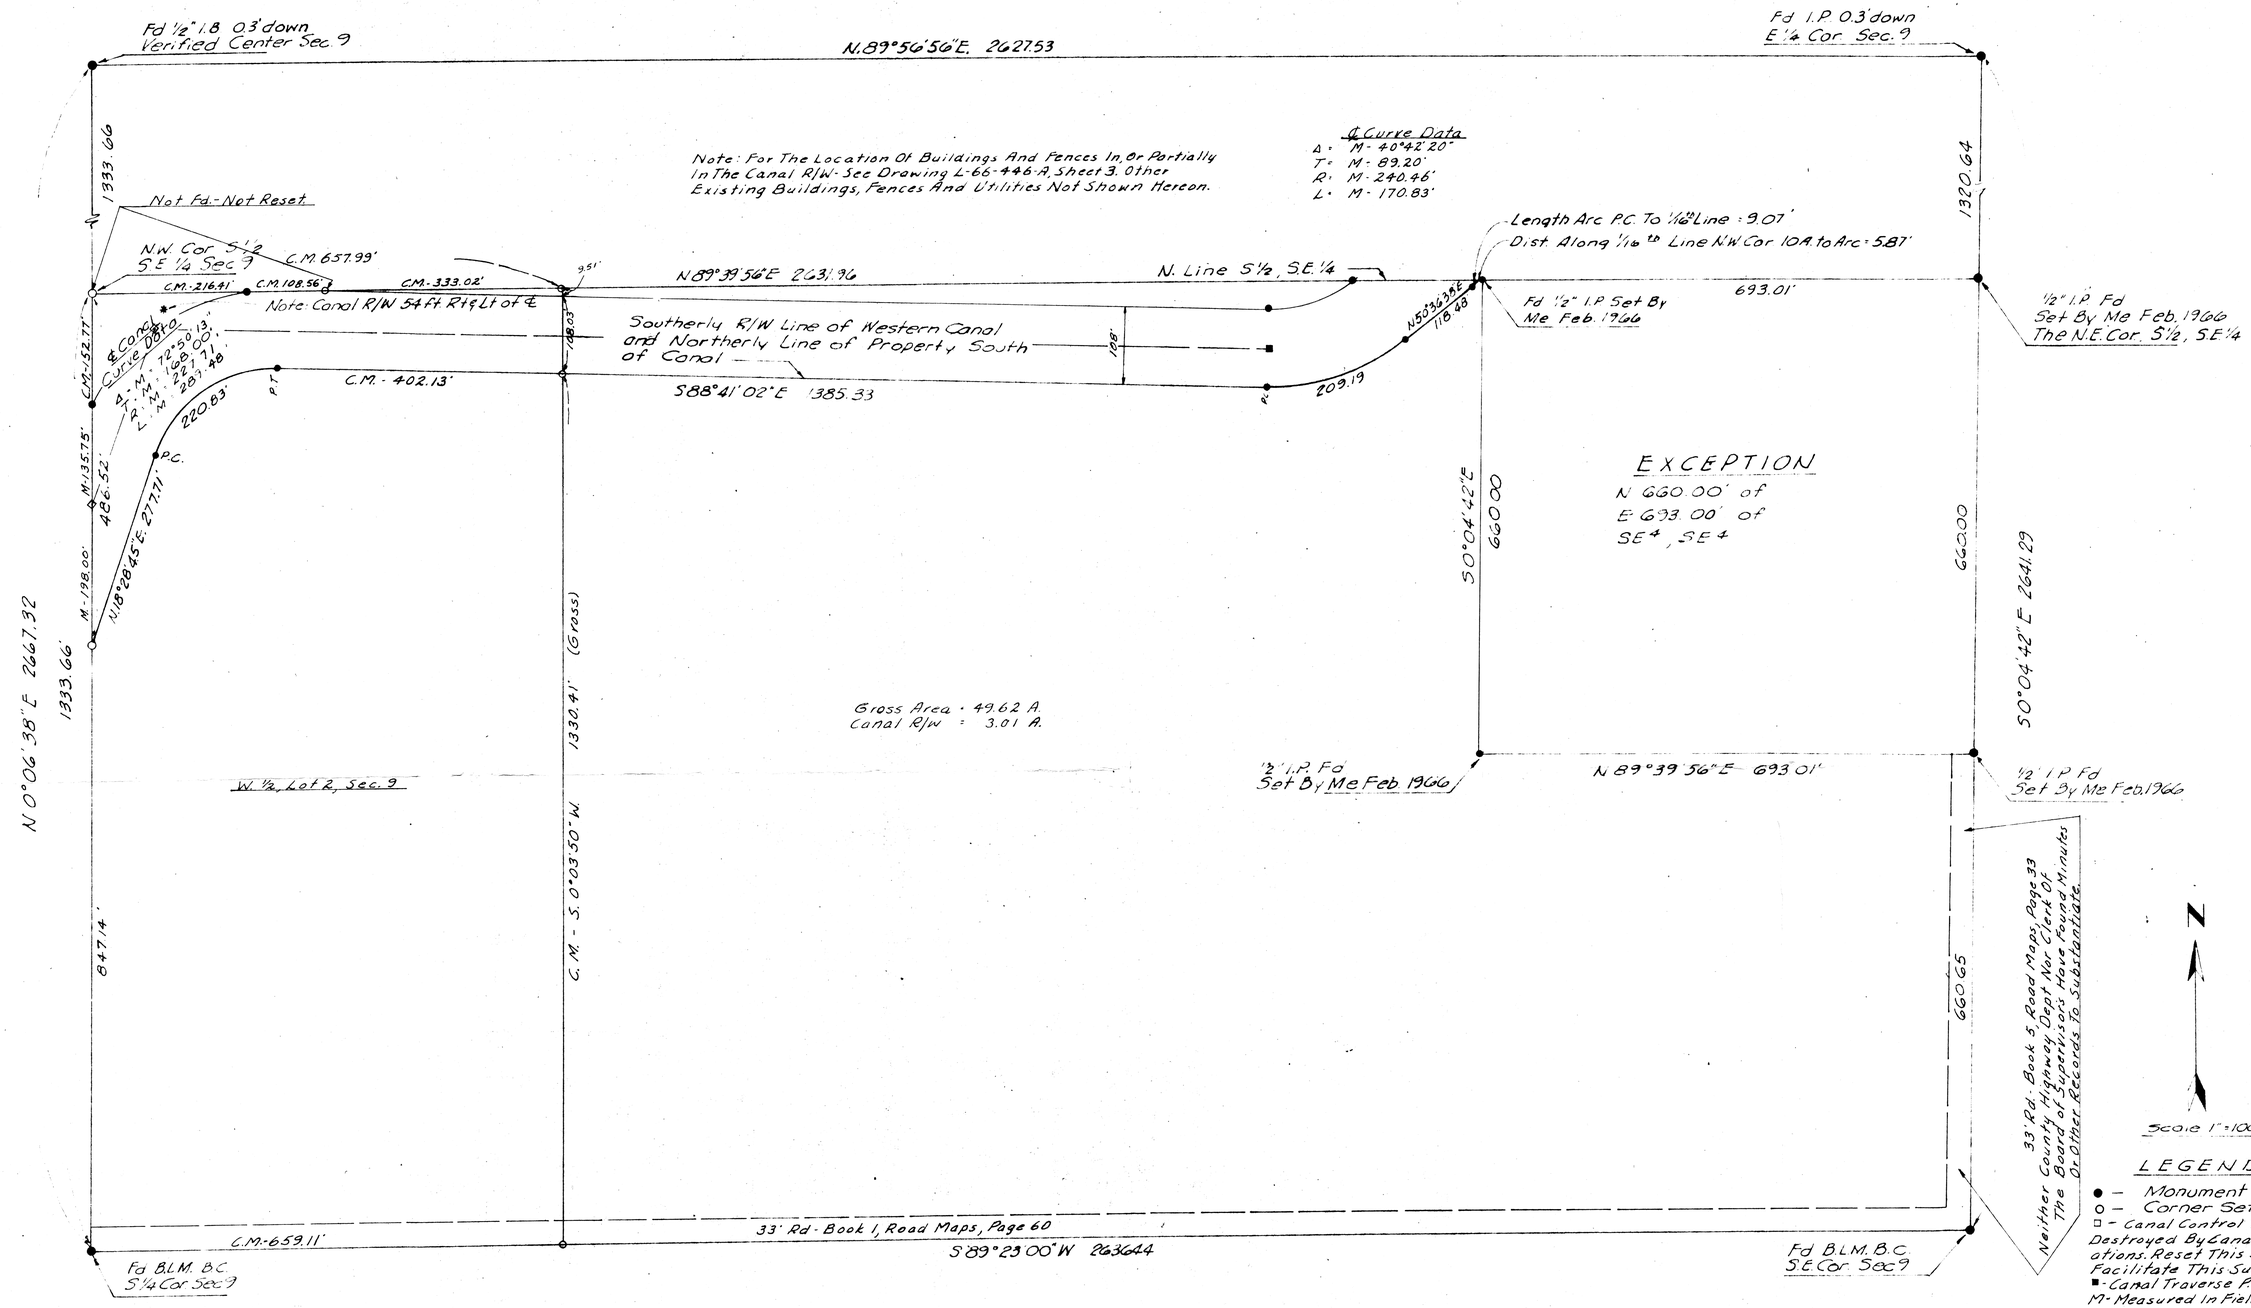

LEGEND

● – Monument Found
○ – Corner Set This Survey
□ – Canal Control Traverse P.I.'s Destroyed By Canal Lining Operations. Reset This Survey To Facilitate This Survey.
■ – Canal Traverse P.I. Found.
M – Measured In Field, C.M. = Calc. From M.

This certify that the survey of the west ½, Lot 2, Sec. 9 shown hereon was done by me in February and May, 1969, & that this is the parcel described in Docket 7437, Page 400, M.C.R.

Eugene V. Shelley 8/16/69

REPORT OF SURVEY

OF

That Portion of the S½, S.E. ¼, Sec. 9, T.1.S., R.2.E., G. & S.R.B. & M., Mar. Co. Arizona Lying South of the Southerly Right-of-Way Line of the Western Canal, EXCEPT the N 660.00 feet of the East 693.00 feet thereof. Containing 63.85 A.

For

Mrs. Lula S. Hull
Laveen, Arizona

DIN 60290

This will certify that the survey shown hereon was made by me during Oct.-Nov. 1966 and Jan. 1967.

Eugene V. Shelley 1-23-67

Revised To Make Distance From ℄ Canal To The S. ¼ Cor. Sec. 9 Conform To M.C.R.

Eugene V. Shelley 7/3/67

Note:
1- This Drawing amends Drawing L-66-446
2- For Portions Lying North of Canal See Drawing L-66-446-A

ARIZONA SURVEYING SERVICE
~~1114 N 7th ST~~ PHOENIX, ARIZONA
Drawing No. ~~L-66-446-B~~ L-69-1546-A
2802 W. Solano Dr., North