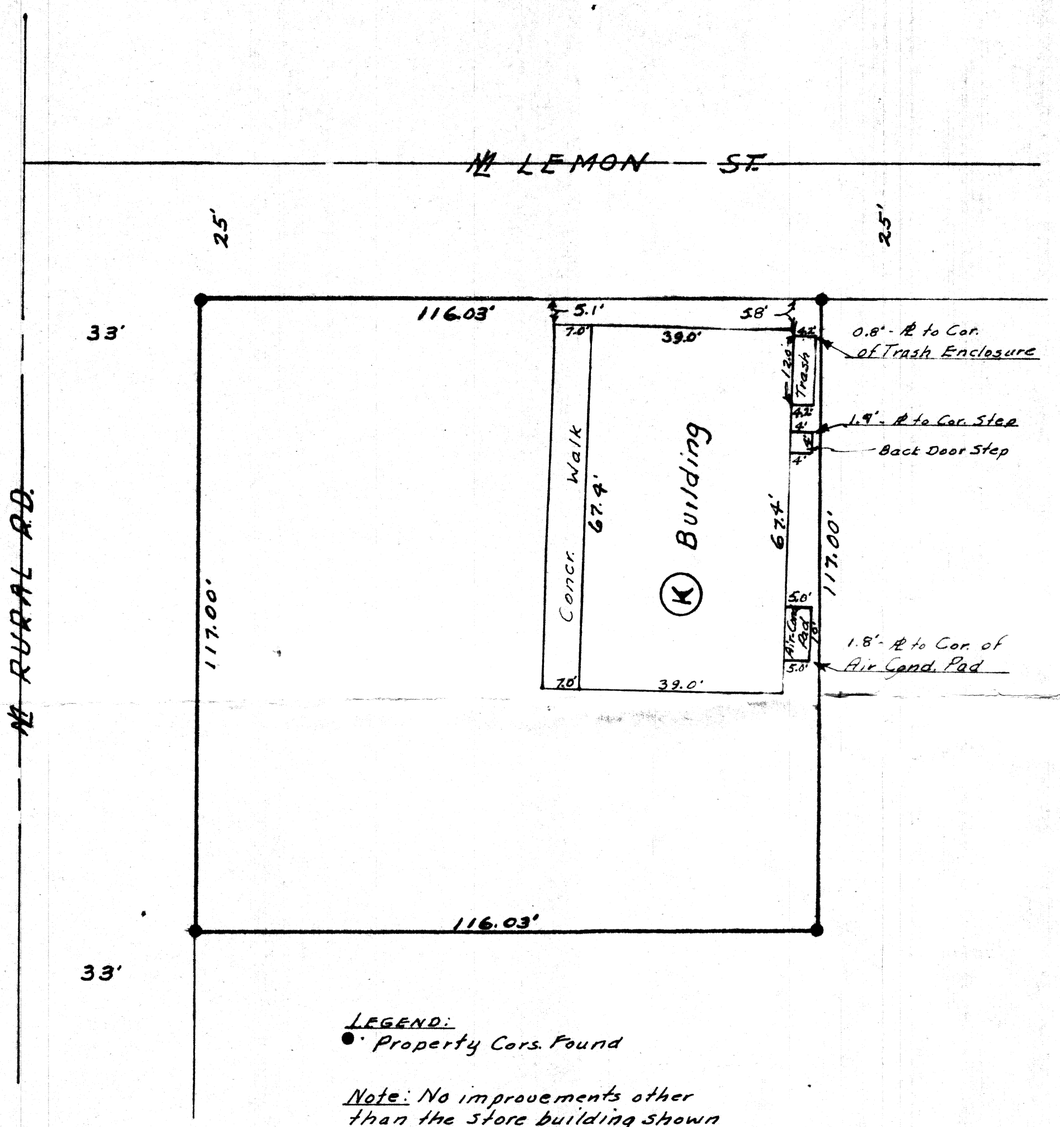

LEGEND:
● Property Cors. Found

Note: No improvements other than the store building shown hereon. For existing street paving, curb and sidewalk, see drawing No. L-64-356

REPORT OF SURVEY "AS-BUILT" LOCATION OF THE (K) STORE BLDG.

ON That part of the N.W. ¼ of Sec. 23, T. 1 N., R. 4 E., G. & S. R. B. & M. described in the map of Survey in evidence to the resolution of civil action, the Judgement partitioning of which is recorded in Dkt. 773, P. 71, M.C.R., described on said map as the Moraga property and the N. 117.00' of Tracts A & B" shown thereon.

FOR

MSSRS. IRVING SHUMAN, & A. J. PELLIGRINI,
4800 North Central Avenue
PHOENIX ARIZONA

N

Scale, 1" = 20'

This will certify that the survey shown hereon was made by me on Aug 20th, 1964.

Eugene V. Skelly, R.L.S.

ARIZONA SURVEYING SERVICE
1114 N. 7th ST., PHOENIX, ARIZONA
DRAWING No. - L-64-380

DIN 60337