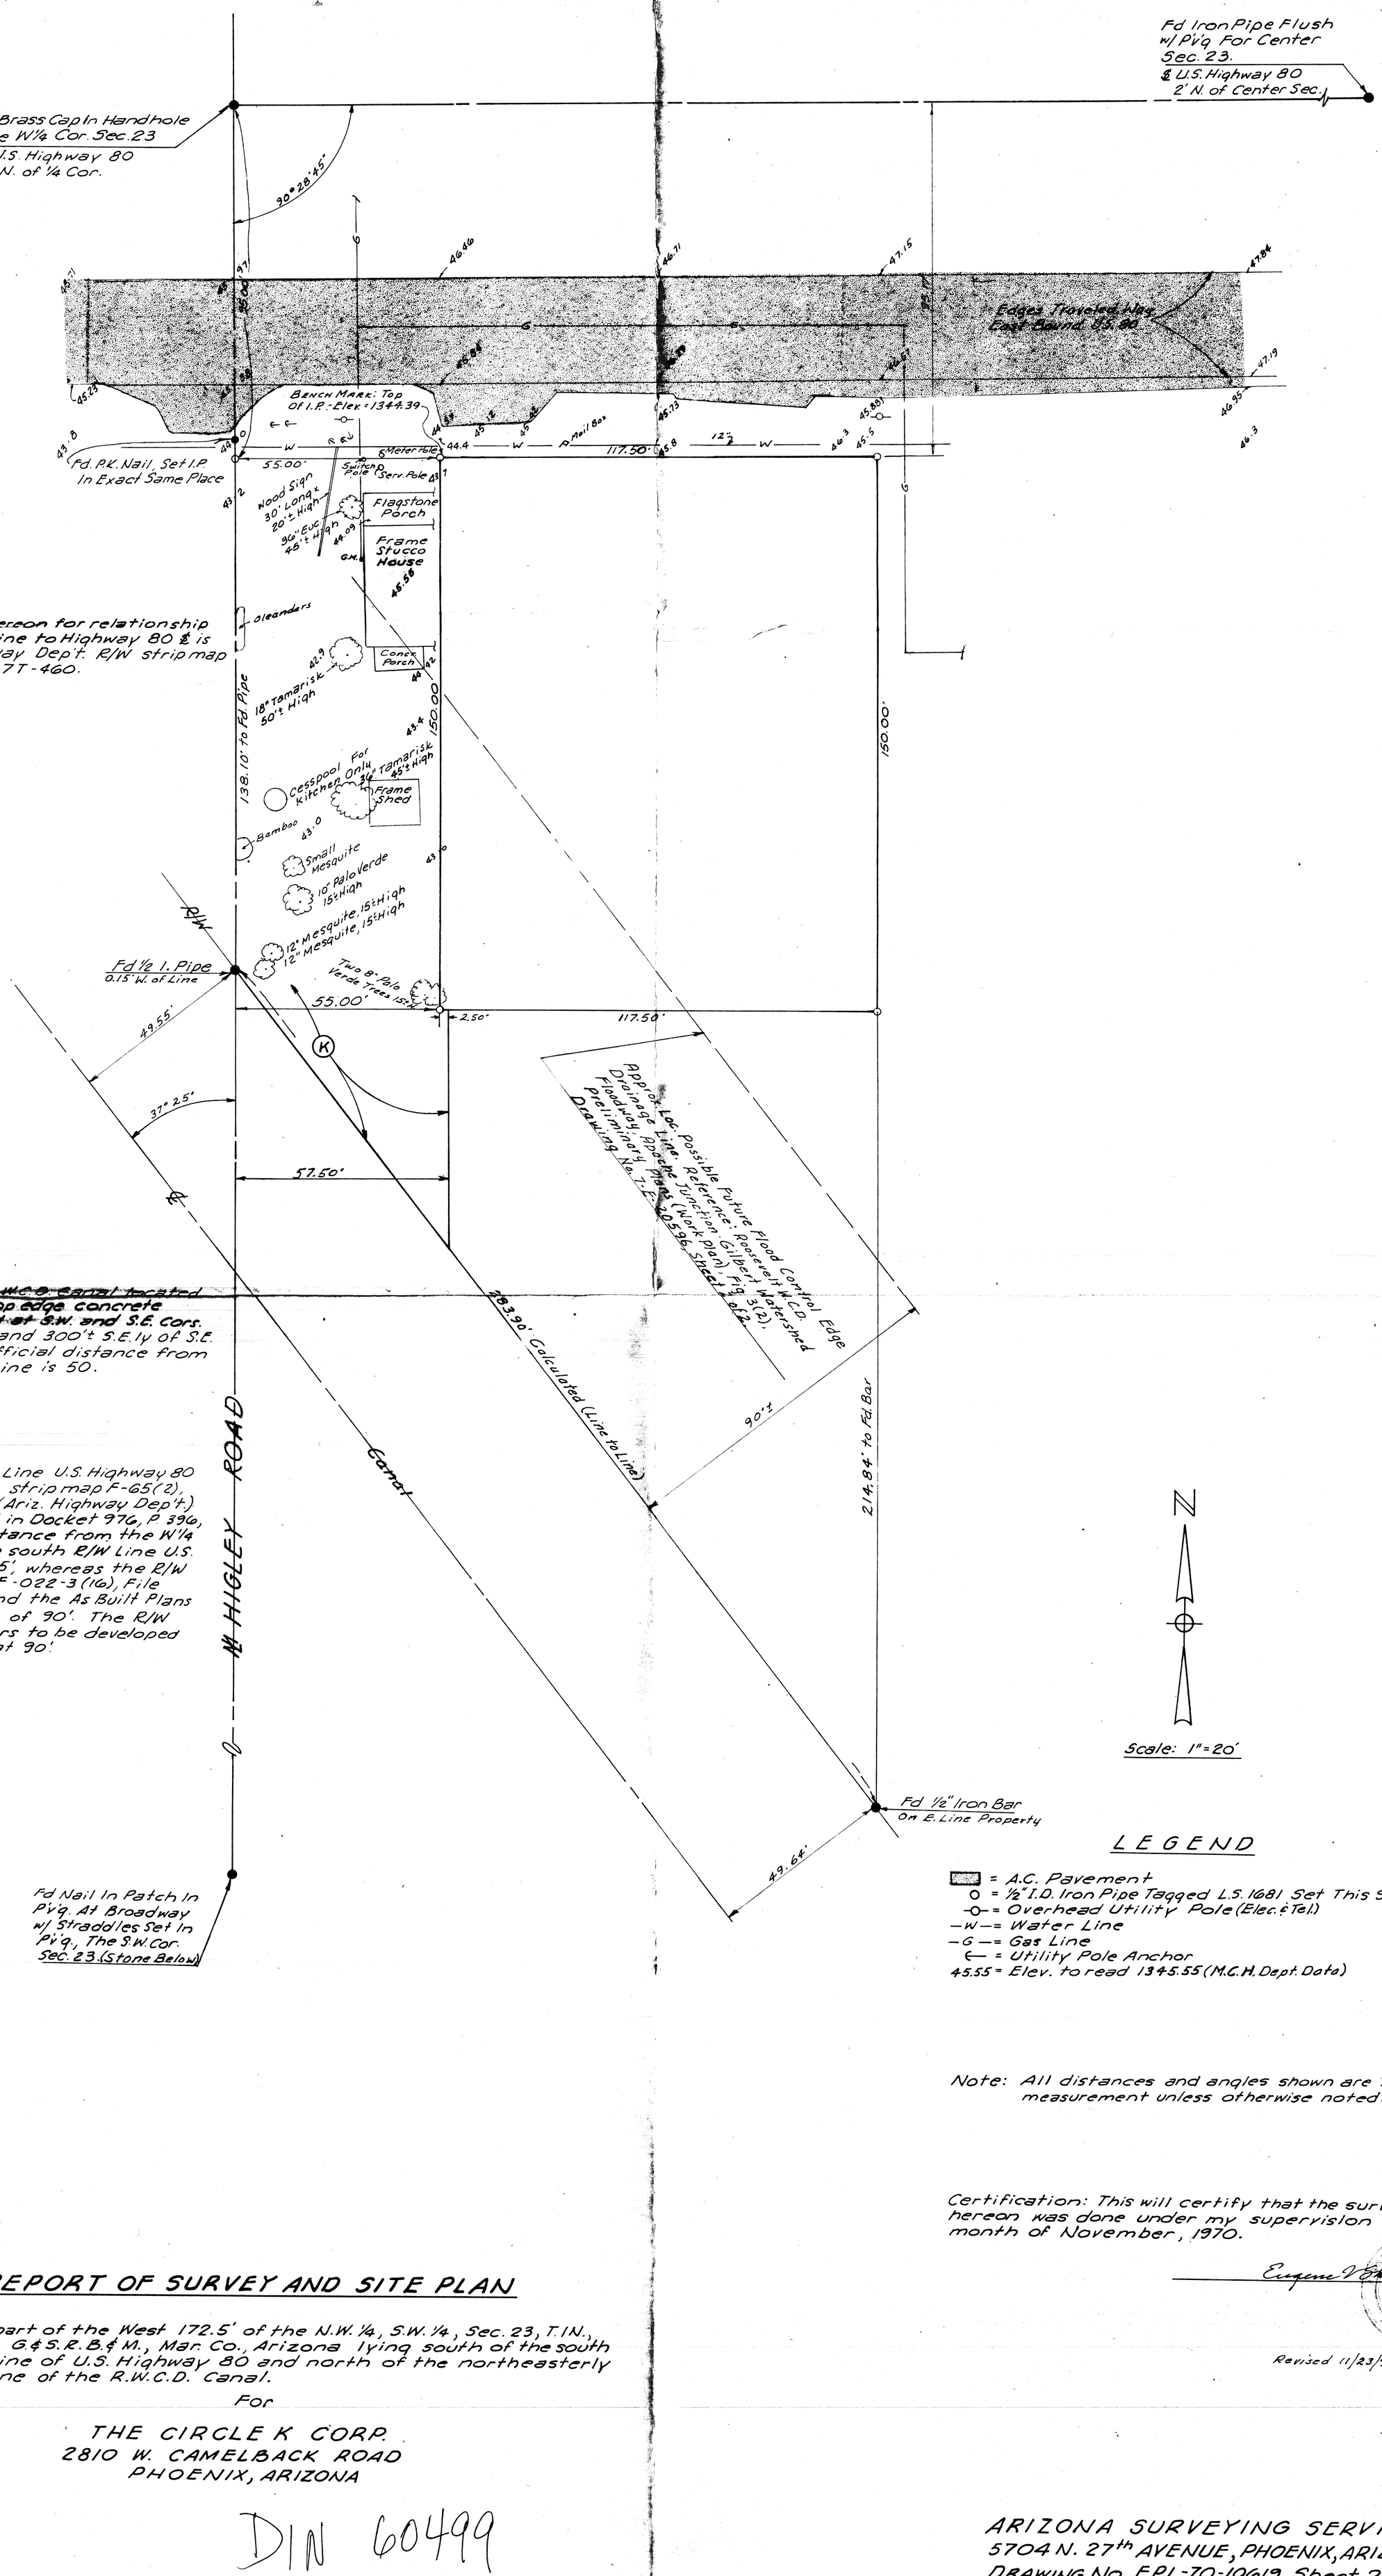

Note:
Data shown hereon for relationship of mid-section line to Highway 80 ℄ is from Ariz. Highway Dep't. R/W strip map F-65(2), File No. 7T-460.

Note:
~~℄ canal is ℄ R.W.C.D. canal located~~ ~~by mid-split of top edge concrete linings measured at S.W. and S.E. Cors.~~ of parcel shown and 300'± S.E.ly of S.E. Cor property. Official distance from ℄ canal to R/W Line is 50.

Note:
The south R/W Line U.S. Highway 80 as shown on R/W strip map F-65(2), File No. 7T-460 (Ariz. Highway Dep't.) and as described in Docket 976, P. 396, M.C.R. set the distance from the W1/4 Cor. Sec 23 to the south R/W Line U.S. Highway 80 at 95', whereas the R/W strip map Non F-022-3(16), File No. A-7-T-650 and the As Built Plans show a distance of 90'. The R/W Line also appears to be developed on the ground at 90'.

LEGEND

- = A.C. Pavement
- o = 1/2" I.D. Iron Pipe Tagged L.S. 1681 Set This Survey
- -o- = Overhead Utility Pole (Elec. & Tel.)
- —W— = Water Line
- —G— = Gas Line
- ← = Utility Pole Anchor
- 45.55 = Elev. to read 1345.55 (M.C.H. Dept. Data)

Note: All distances and angles shown are field measurement unless otherwise noted.

Certification: This will certify that the survey shown hereon was done under my supervision during the month of November, 1970.

Eugene V. Shelley
11/18/70

Revised 11/23/70 E.V.S.

REPORT OF SURVEY AND SITE PLAN

That part of the West 172.5' of the N.W. 1/4, S.W. 1/4, Sec. 23, T.1N., R.6E., G.&S.R.B.&M., Mar. Co., Arizona lying south of the south R/W line of U.S. Highway 80 and north of the northeasterly R/W line of the R.W.C.D. Canal.

For

THE CIRCLE K CORP.
2810 W. CAMELBACK ROAD
PHOENIX, ARIZONA

DIN 60499

ARIZONA SURVEYING SERVICE
5704 N. 27th AVENUE, PHOENIX, ARIZONA
DRAWING No. EPL-70-10619 Sheet 2 of 2

EPL-71-4642 (R)