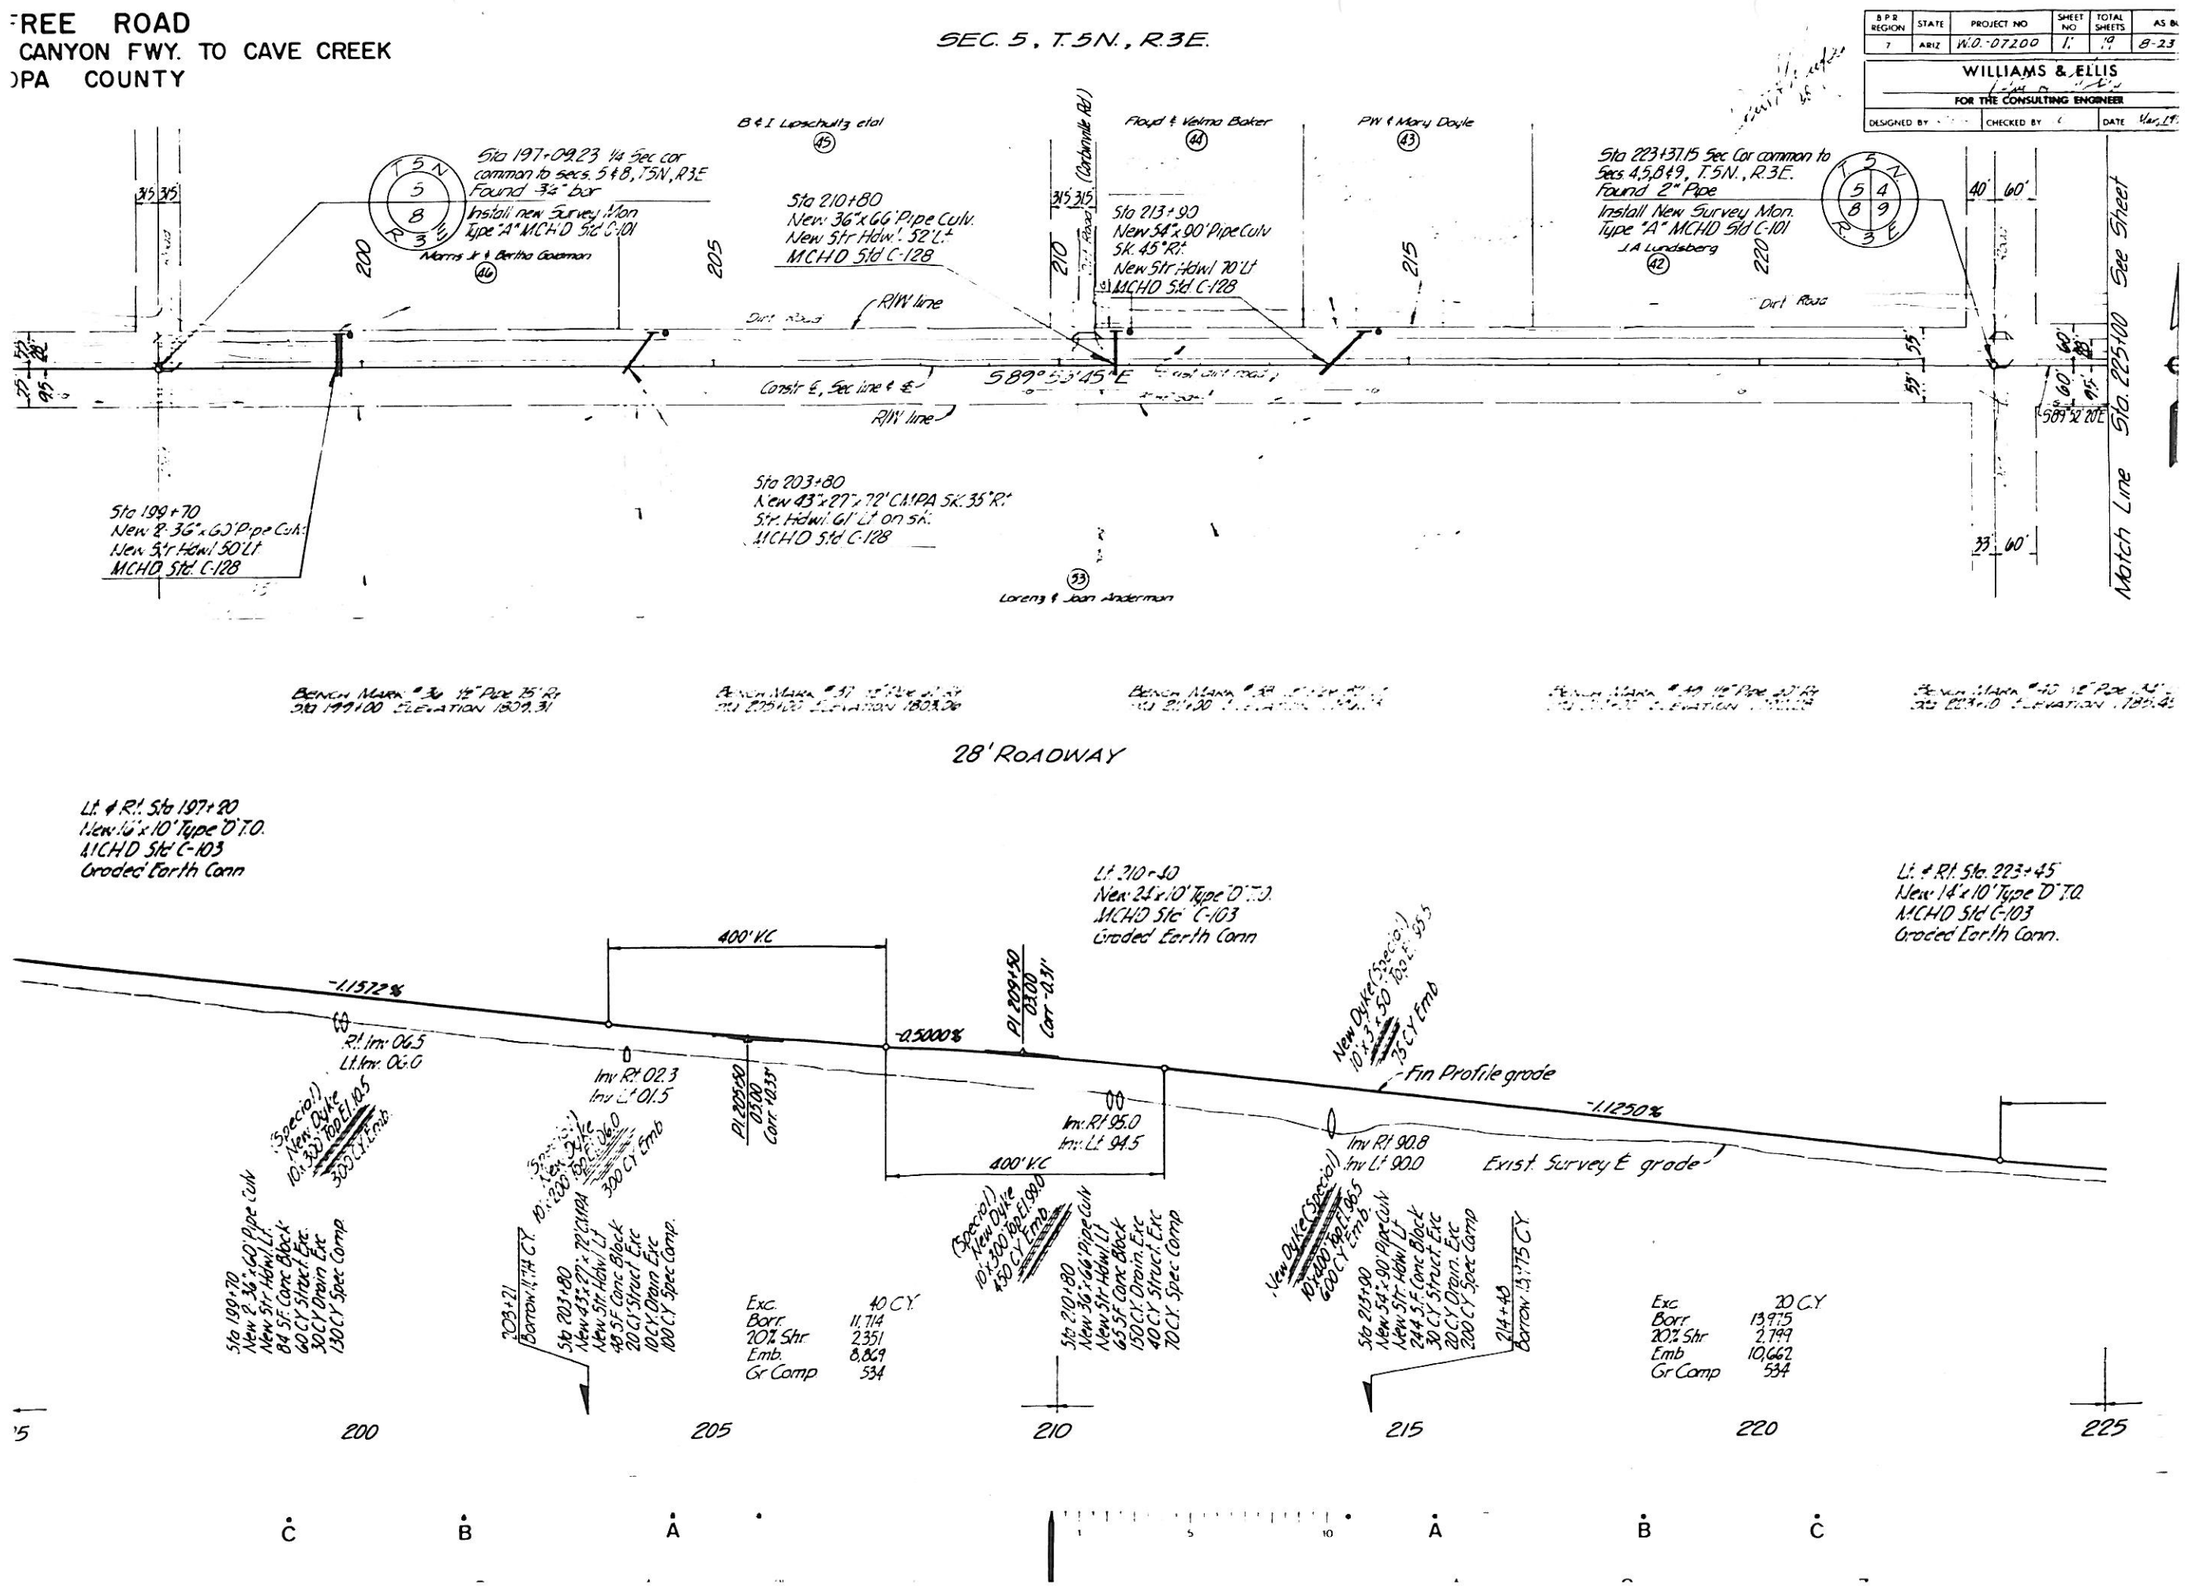

B P R REGION	STATE	PROJECT NO	SHEET NO	TOTAL SHEETS	AS BU
7	ARIZ	W.O.-07200	1	19	8-23

WILLIAMS & ELLIS
FOR THE CONSULTING ENGINEER
DESIGNED BY | CHECKED BY | DATE

REE ROAD
CANYON FWY. TO CAVE CREEK
PA COUNTY

SEC. 5, T.5N., R.3E.

B.P.R. REGION	STATE	PROJECT NO.	SHEET NO.	TOTAL SHEETS	AS BUILT
7	ARIZ	W.O.-07200	10	19	8-23-7

WILLIAMS & ELLIS
FOR THE CONSULTING ENGINEER
DESIGNED BY CHECKED BY DATE Mar. 1958

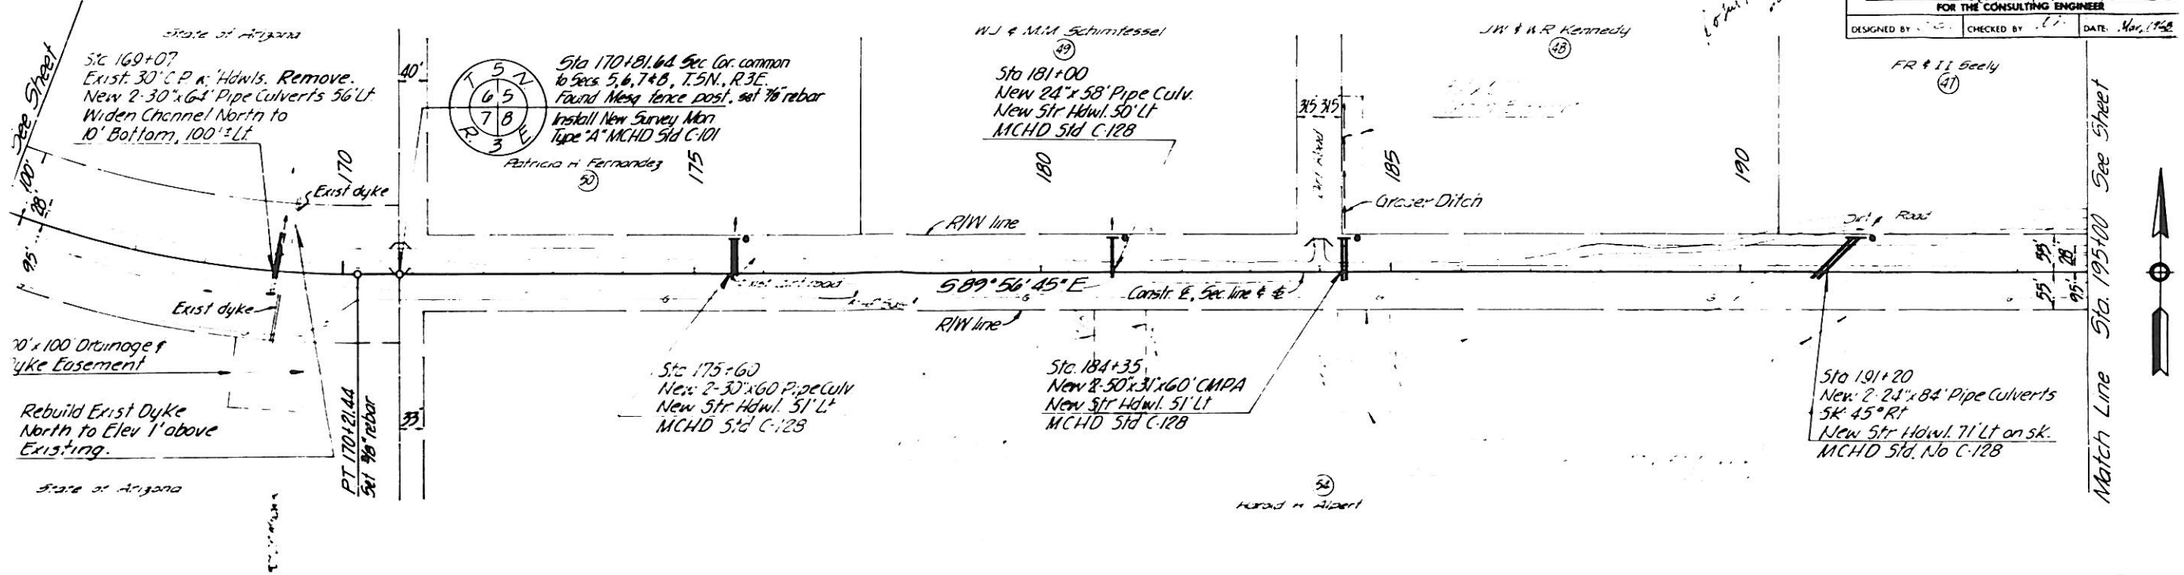

28' ROADWAY

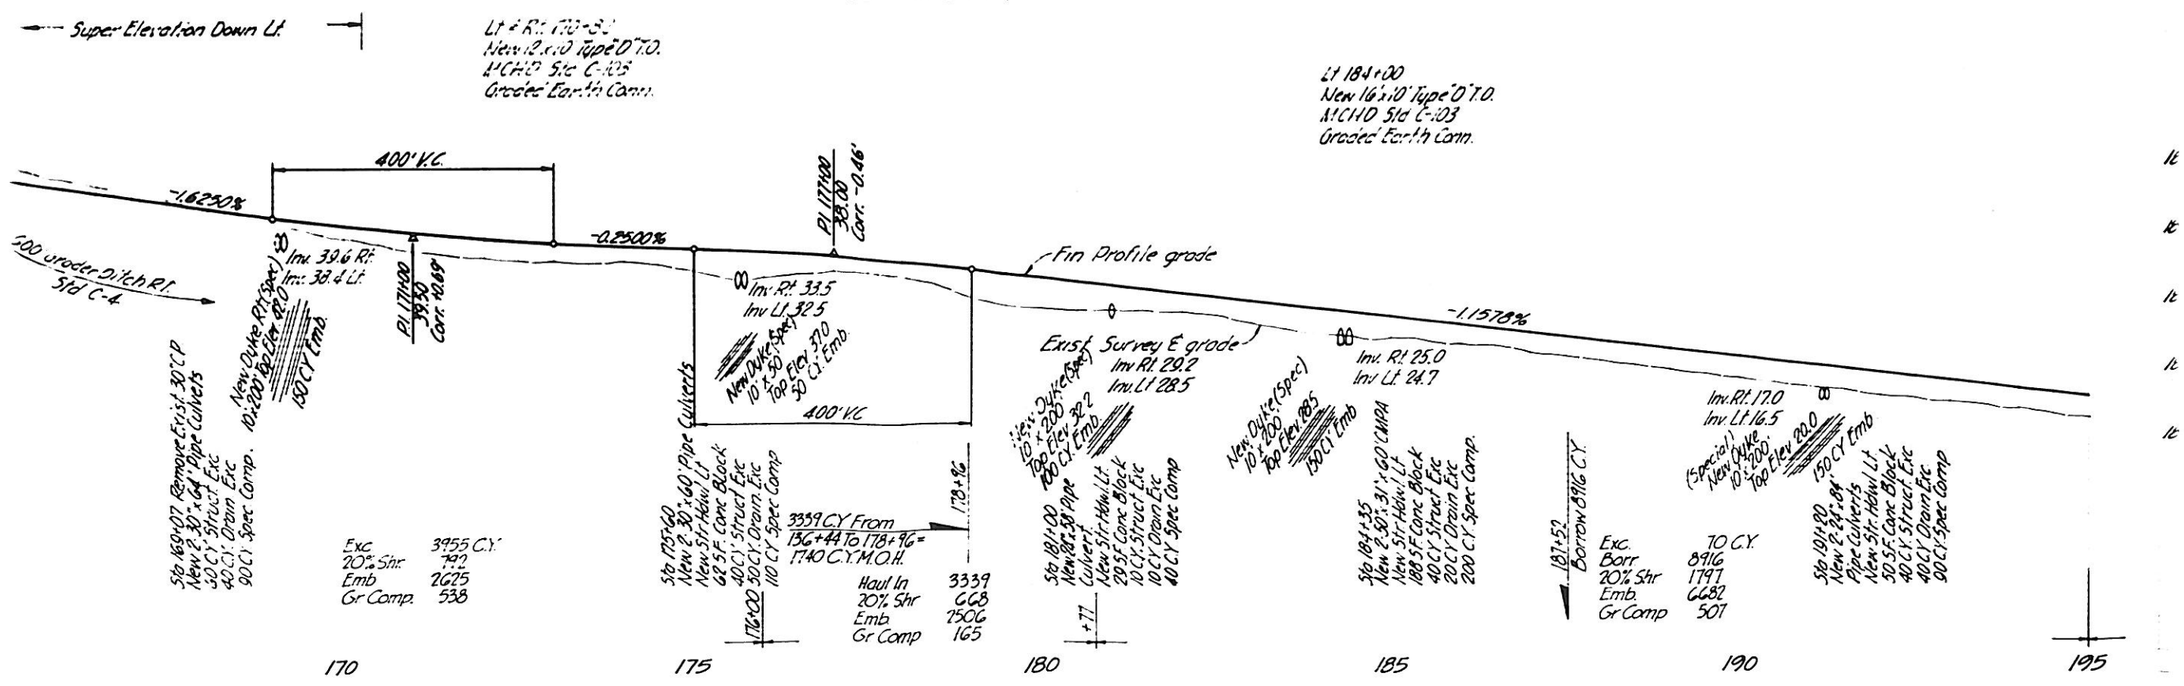

DIN# 61868