RESULTS of SURVEY of a portion of the N.W.'rly R/W, SKUNK CREEK Channel, within Sec.'s 2 & 11, T3N, R1E, G&SRB&M, Maricopa County, Arizona; PG. 3 of 3

Surveyor's Comments

The legal descriptions (R4 on page one) establishing the N.W.'rly R/W line of said channel, across the W2NE4, SE4, & extending into the SW4 (all in Sec. 2) are in slight conflict. In order to be in harmony with adjacent legal description for the R/W line lying in the E2NE4 of Sec. 2 (R5 on page one), the legal for K-12A-FL1 (marked R4 senior on page one) was used to establish said line.

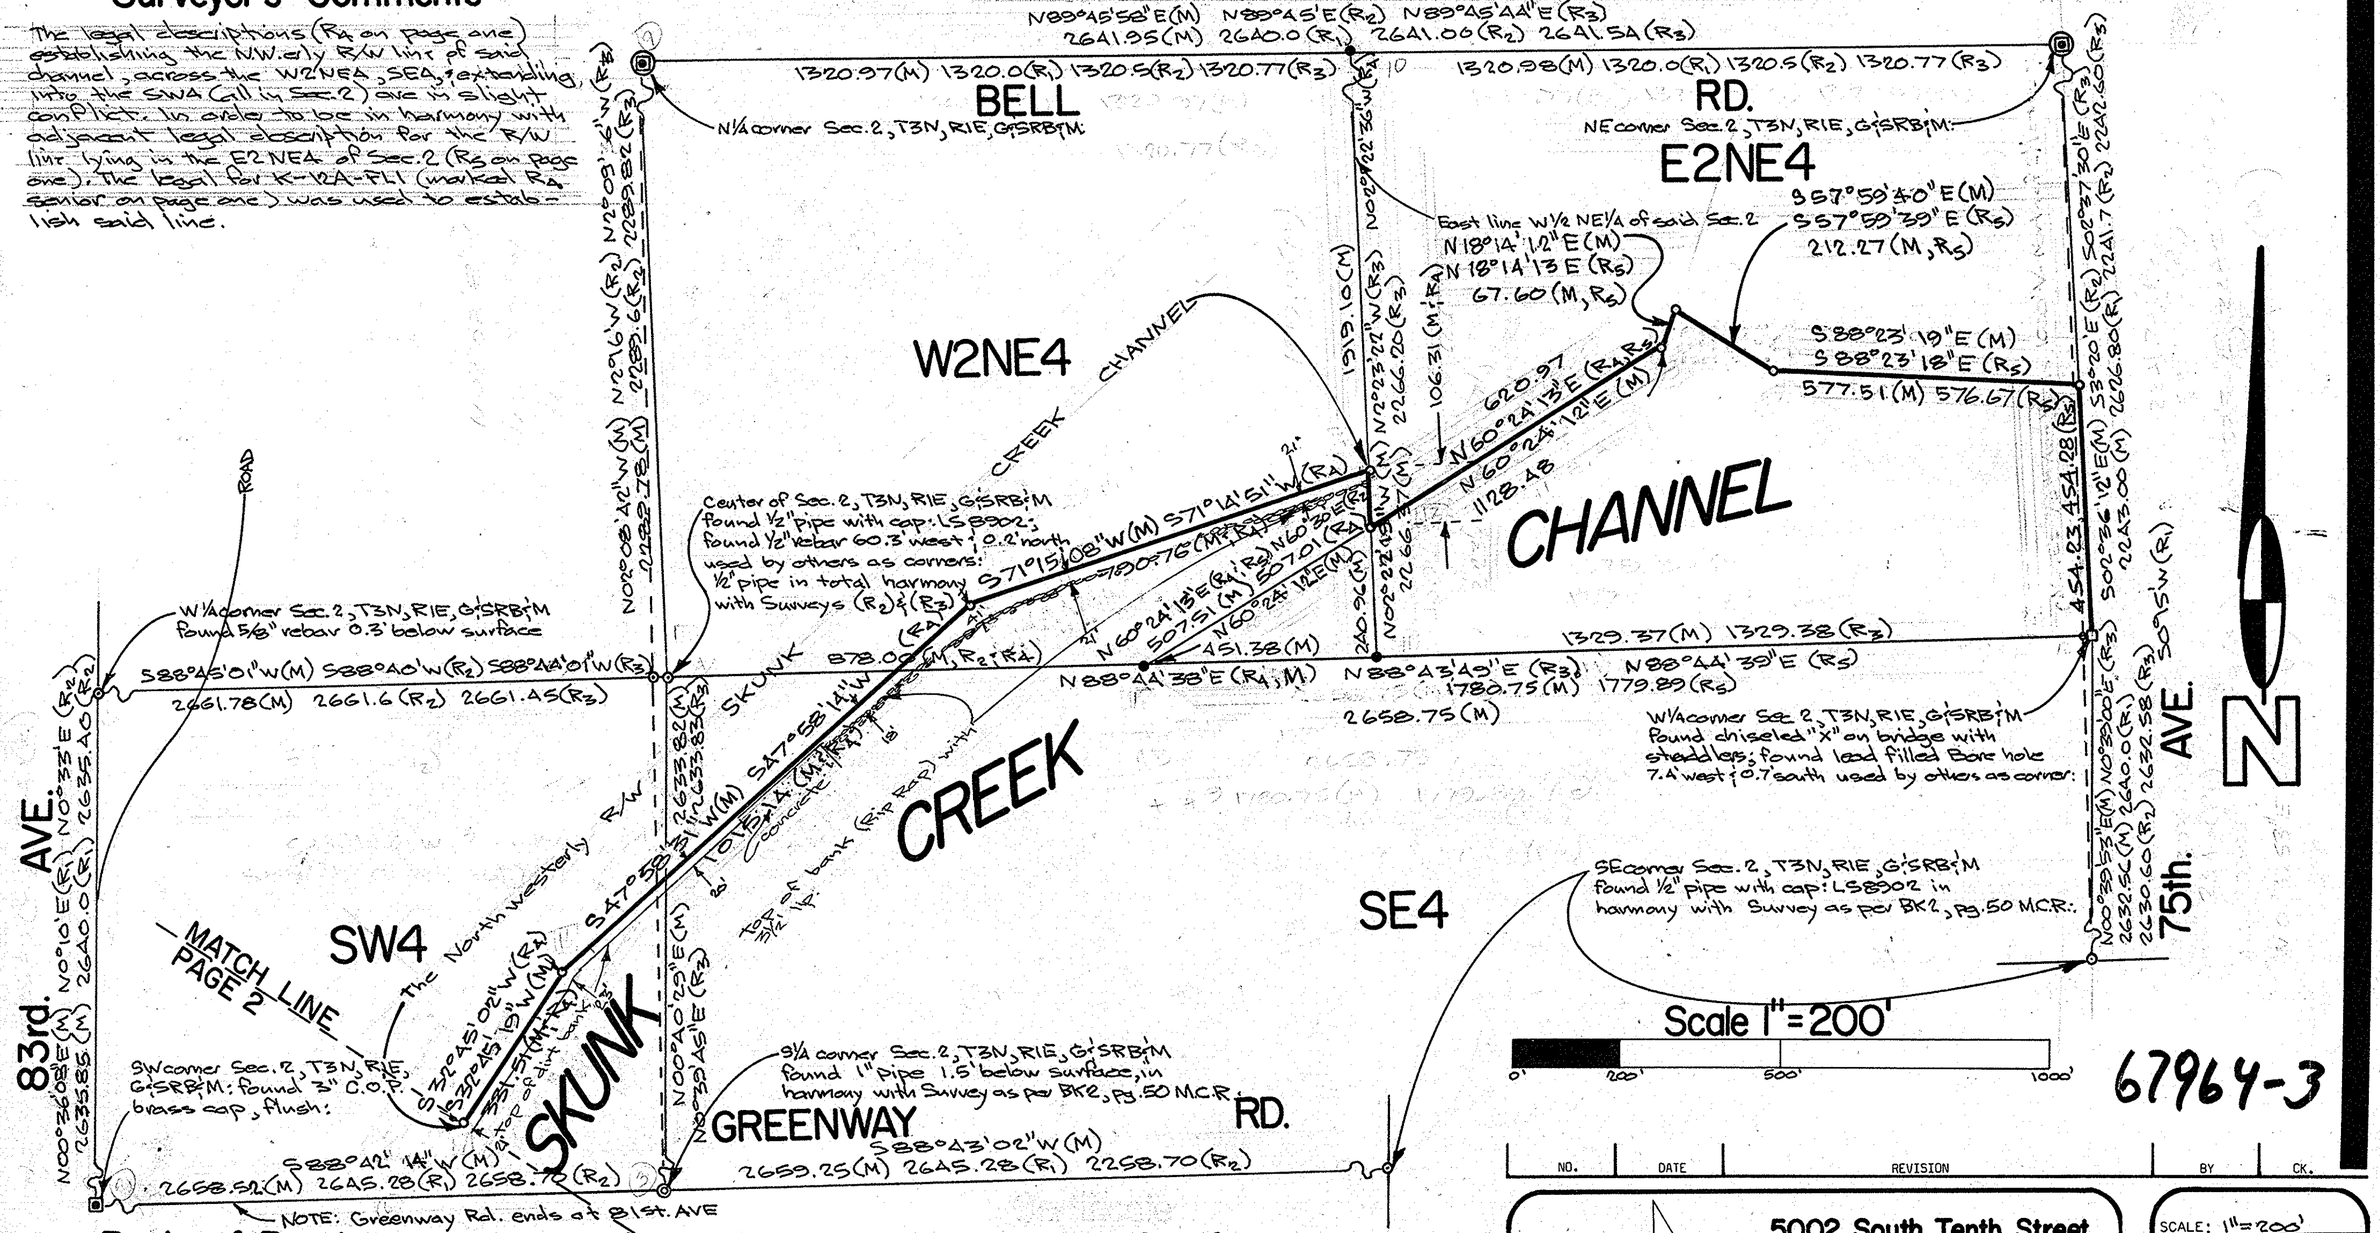

67964-3

NO.	DATE	REVISION	BY	CK.

Basis of Bearings

The South line of the NE1/4 of said Sec. 2: N88°44'38"E: as per parcel acquisition legal description found in

Legend

- found 3" MCHD brass cap in hand hole
- nothing found or set
- o set 1/2" rebar with plastic cap
- (M) measured information
- (R1) B.L.M. info as per Plat T3N, R1E Filed 12-2-1870
- (R2) unrecorded Survey of W.H. Bartlett, Oct. 1959
- (R3) record Survey BK 2 of Surveys, pg. 50 M.C.R.
- (R4) F.C.D.M.C. legal description: K-12A-FL1, K-12A-FL2
- (R5) : T-13: Int. 87-561130
- (R6) : K-6-FL:
- (R7) : K-8A-FL2
- (R8) : K-9A-FL3
- (R9) : K-9A-FL2

Certificate

I hereby certify to F.C.D.M.C. that the survey shown hereon was performed on the ground and under my direction during the months of Dec. 1991 thru Oct., 1992 and is true and correct all to the best of my knowledge and belief.

Ronnie L. Fannin, L.S. 14177

AFFILIATED SURVEYORS INTERNATIONAL
5002 South Tenth Street
Phoenix, Arizona 85040
243-3141

CLIENT:
Flood Control District of Maricopa County
2801 W. Durango Street
Phoenix, Arizona 85009
(602) 506-1501

Contract 90-35-, 17, 19 thru 21

SCALE: 1" = 200'
DESIGNED:
DRAWN: RLF
CHECKED:
DATE: July 15, 1992
JOB NO.: FC920715

SHEET 3 OF 3

File: Skunk